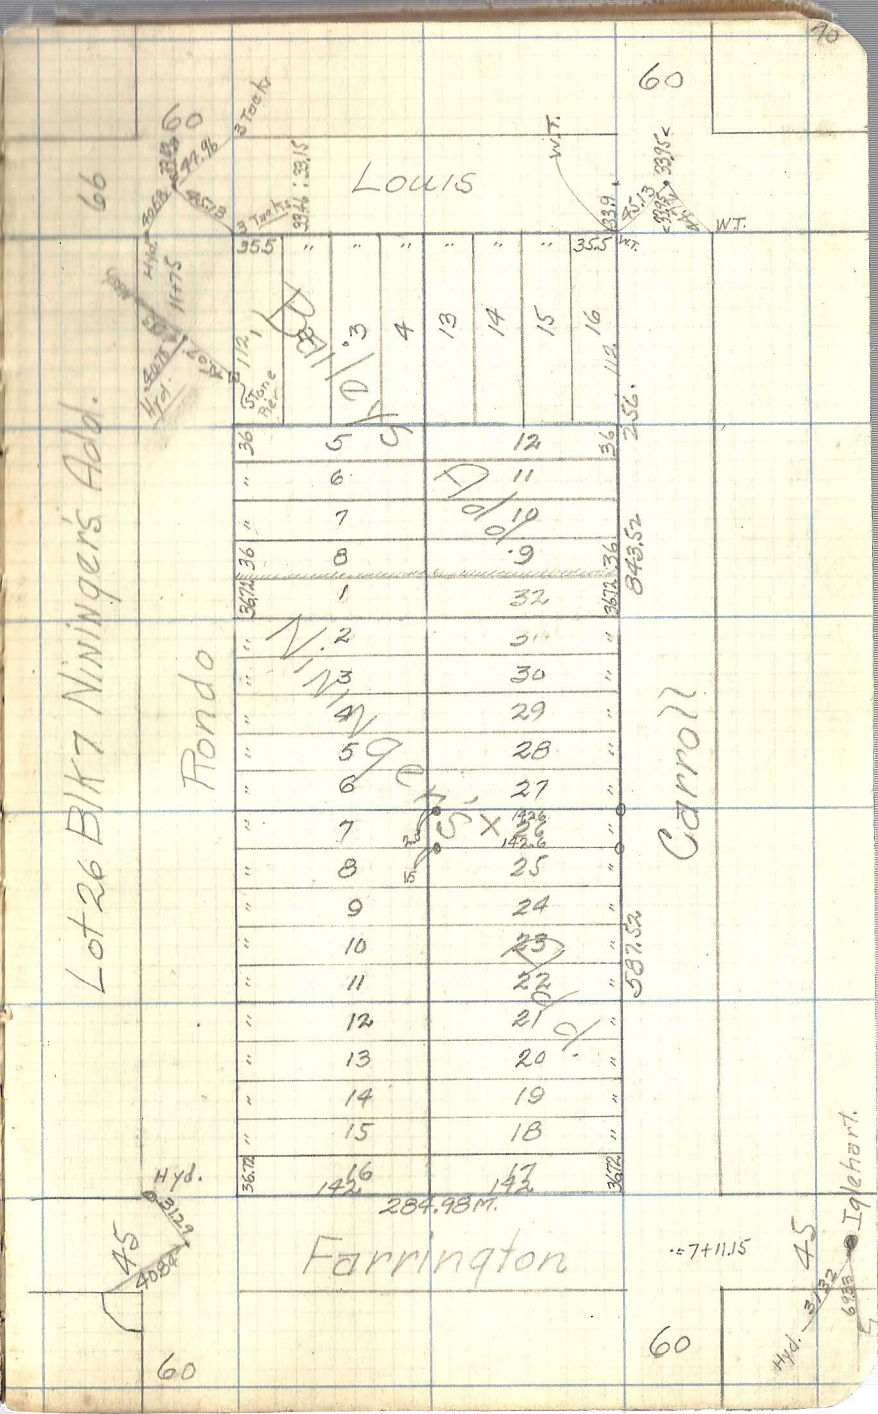
Louis
Rondo
Carroll
Farrington
Lot 26 Blk 7 Ninivgers Add.
3 Trees
W.T.
Hyd.
Stone Pile
Hyd.
Iglehart
284.98M.
343.52
587.52
142.6
355
360
361
362
372
60
45