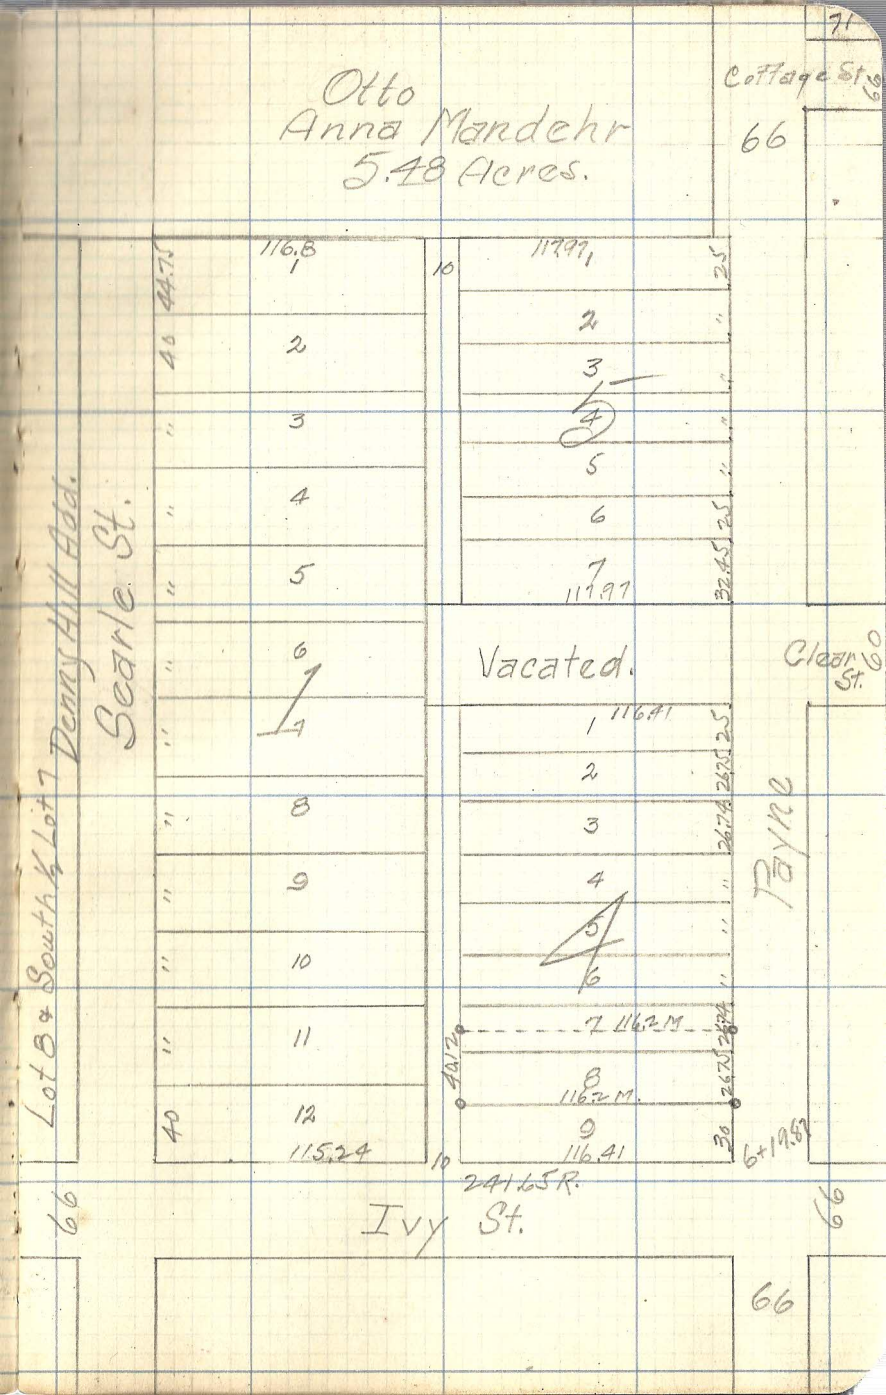
71
Otto
Anna Mandehr
5.48 Acres.
Cottage St.
66
Searle St.
Denny Hill Add.
Lot 8 & South ½ Lot 7
Vacated.
Clear St.
Payne
Ivy St.
116.8
117.97
116.41
116.2 M.
115.24
241.65 R.
6+19.82
44.75
40
10
25
32.45
26.75
26.74
40.12
30
66