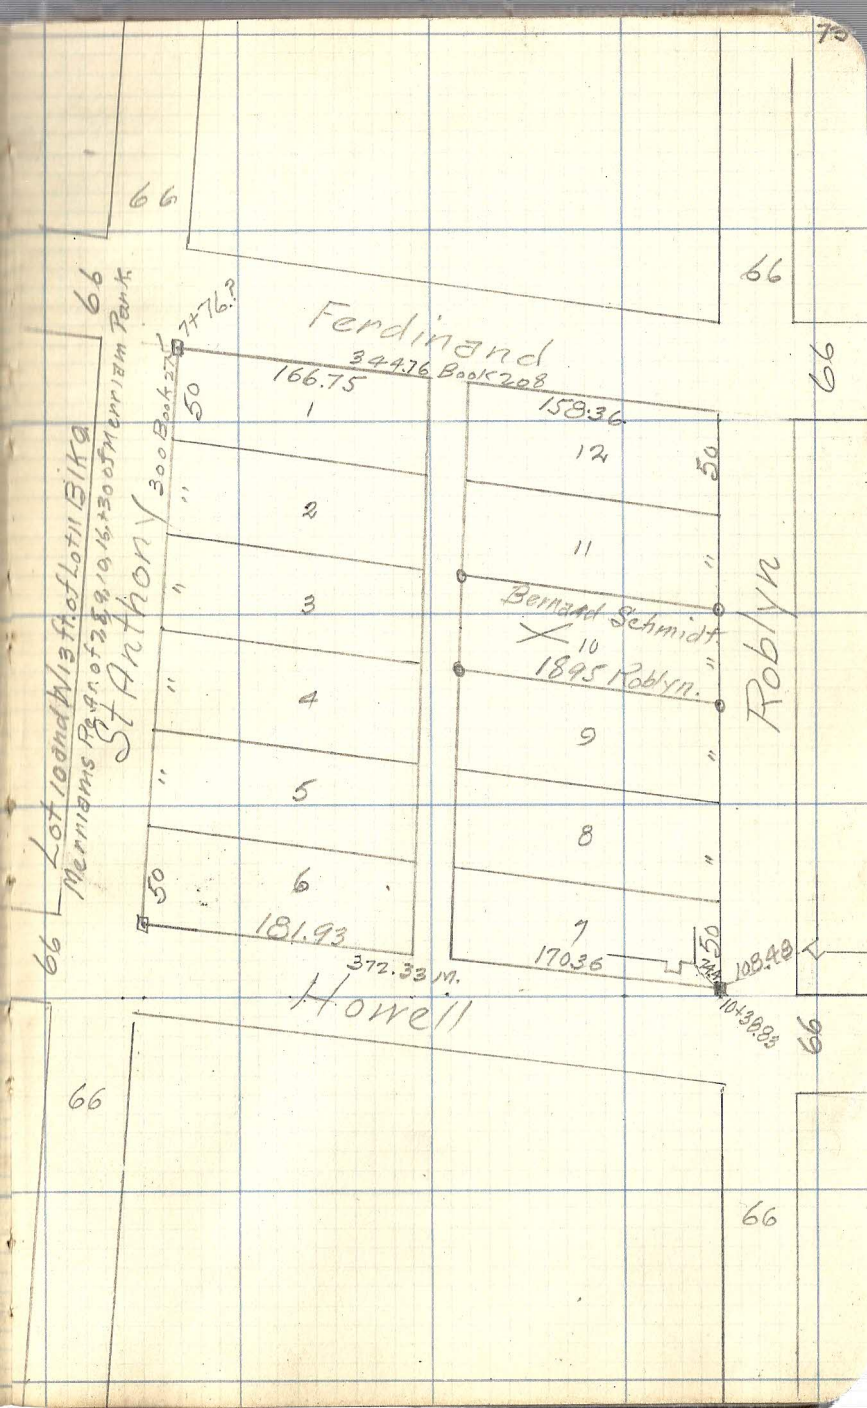
Ferdinand
St Anthony
Robyn
Howell
Bernard Schmidt
1895 Robyn.
Lot 10 and W 13 ft. of Lot 11 Blk 9
Merriams Rearr. of Lots 8, 10, 16, 30 of Merriam Park
166.75
158.36
181.93
170.36
372.33 M.
108.49
104.83
50
66
1
2
3
4
5
6
7
8
9
10
11
12