


120

66

60
Lot 8 B/K. 6 Lyman D. Baird Add.
396.6 M.
60

Sherburne 316.65 M.

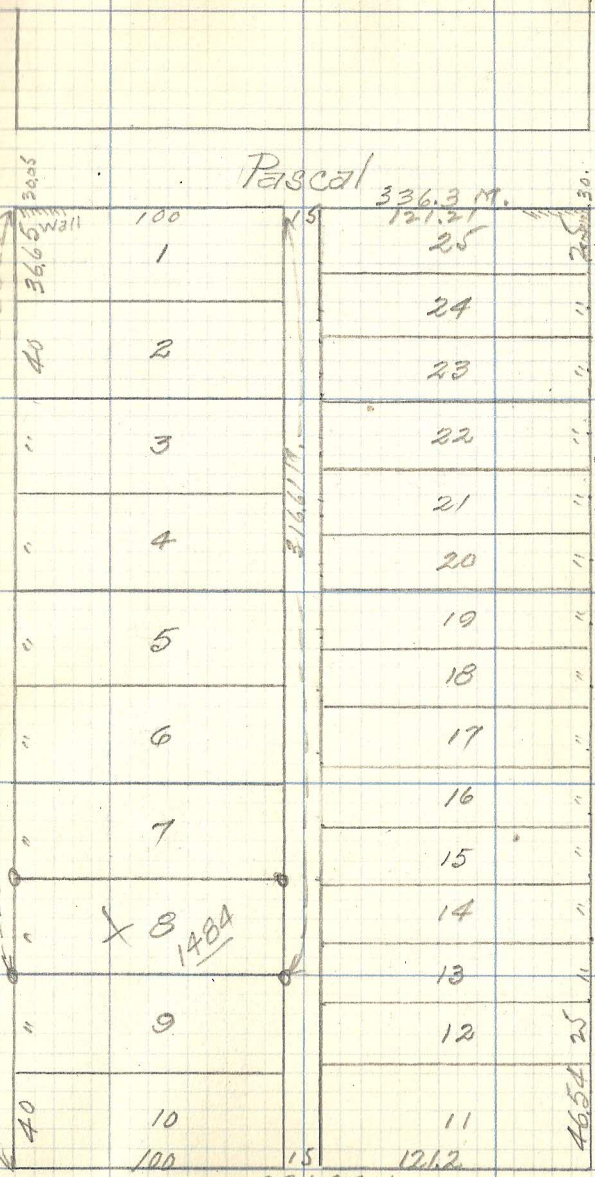

Pascal 336.3 M.
121.21
25

30.
WALL
396.44 M.

University

236.37 M
SIMPSON

66

120

60