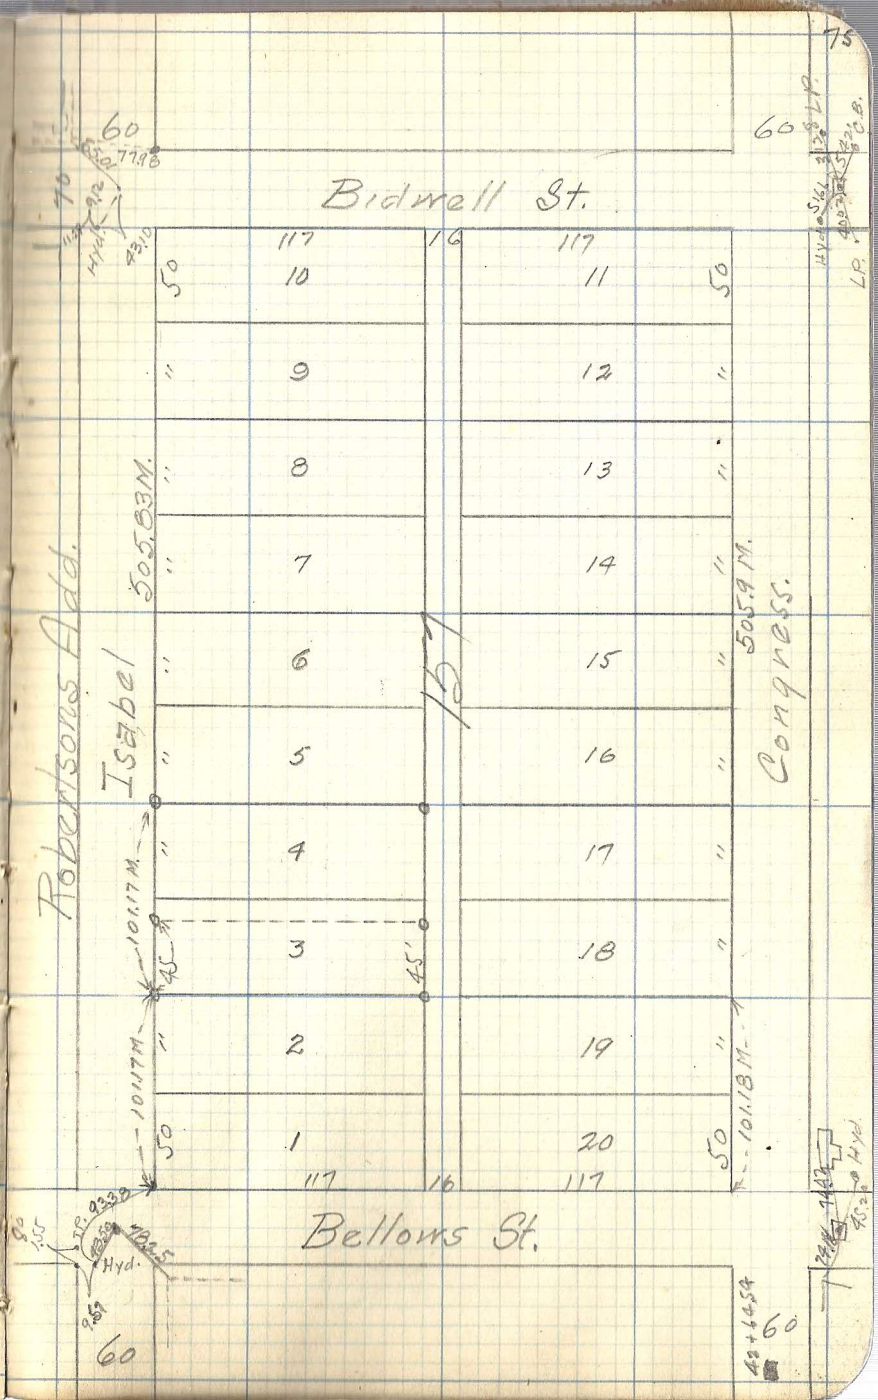
Bidwell St.
Bellows St.
Robertsons Add.
Isabel
505.83 M.
505.9 M.
101.17 M.
101.18 M.
117
16
10
11
9
12
8
13
7
14
6
15
5
16
4
17
3
18
2
19
1
20
45'
50
60
Hyd.