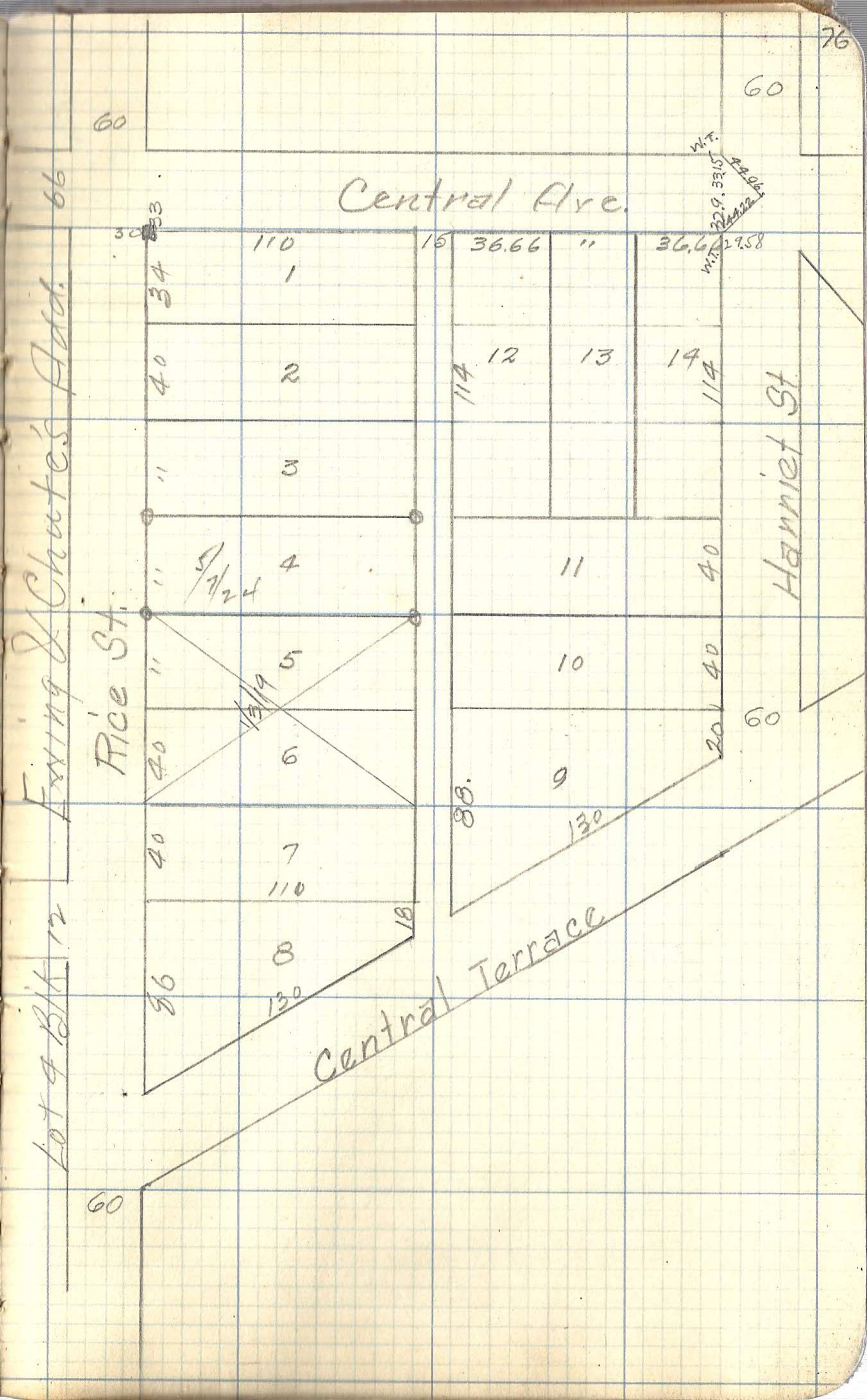
Central Ave.
Rice St.
Central Terrace
Lot 4 Blk 12
W.T.
W.S.
60
66
110
36.66
34
40
114
130
88.
20
16
30
5/1/24
13/19