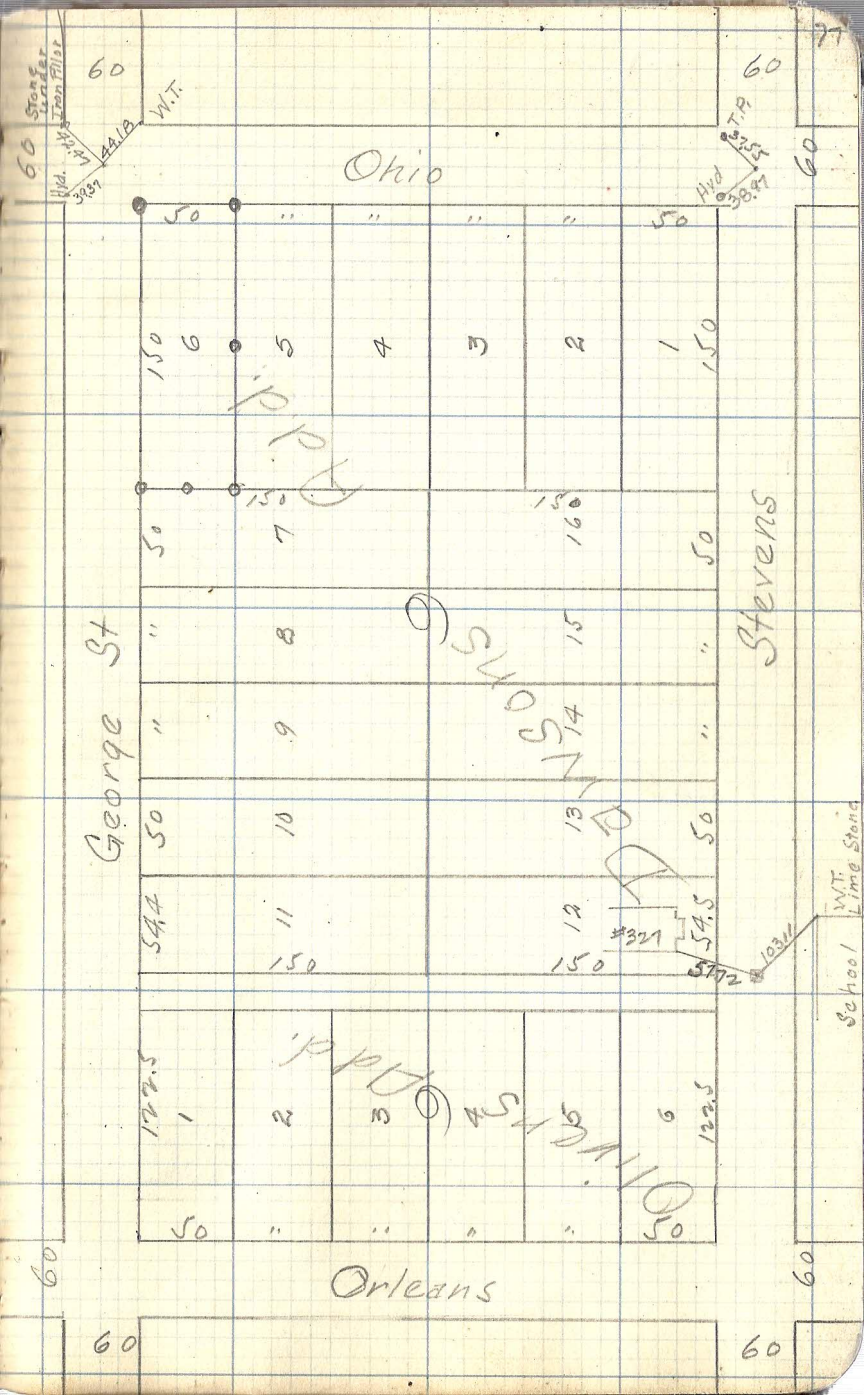
77
Stone under Iron Pillar
W.T.
Hyd.
44.18
39.37
T.P.
37.55
Hyd
38.97
Ohio
George St
Stevens
Orleans
School
W.T. Lime Stone
#321
10311
5772
Dawsons Add.
Olivers Add.
60
50
150
122.5
54.4
54.5
1
2
3
4
5
6
7
8
9
10
11
12
13
14
15
16