


80

80

Cambridge

314.5 R+M.

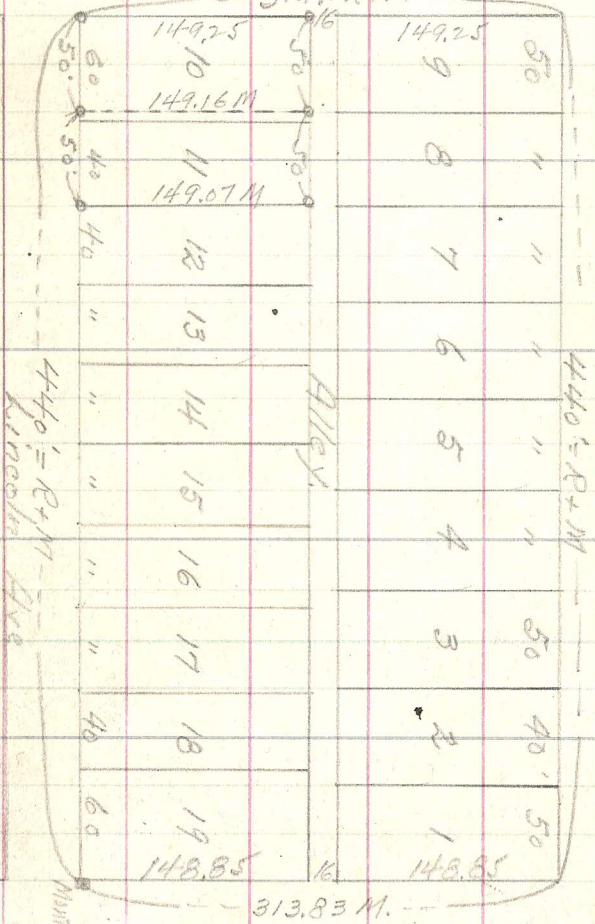

0 = IRONS

Re Ar of lots 10 + 11 B/K. 6
 Re Ar of Morrison's
 Part of Macalester Park
 Re Ar.

440' = R+M
 Lincoln Ave

Alley

2-6-30
 2041

Macalester Ave

80

