


Warrens & Winslows Add. Blk 10

The north 35' of Lot 5 + the south 5' of the east 1/2 of Lot 6

Otsego

Mt. Ida

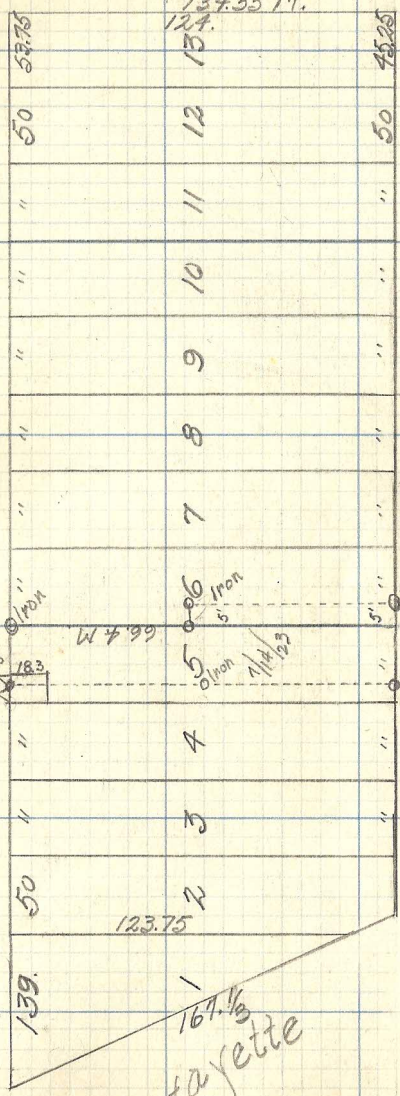

Desoto

Beaumont.  
66

Lafayette

Mrs Tony Zagaria  
655 Desoto

July. 14-23