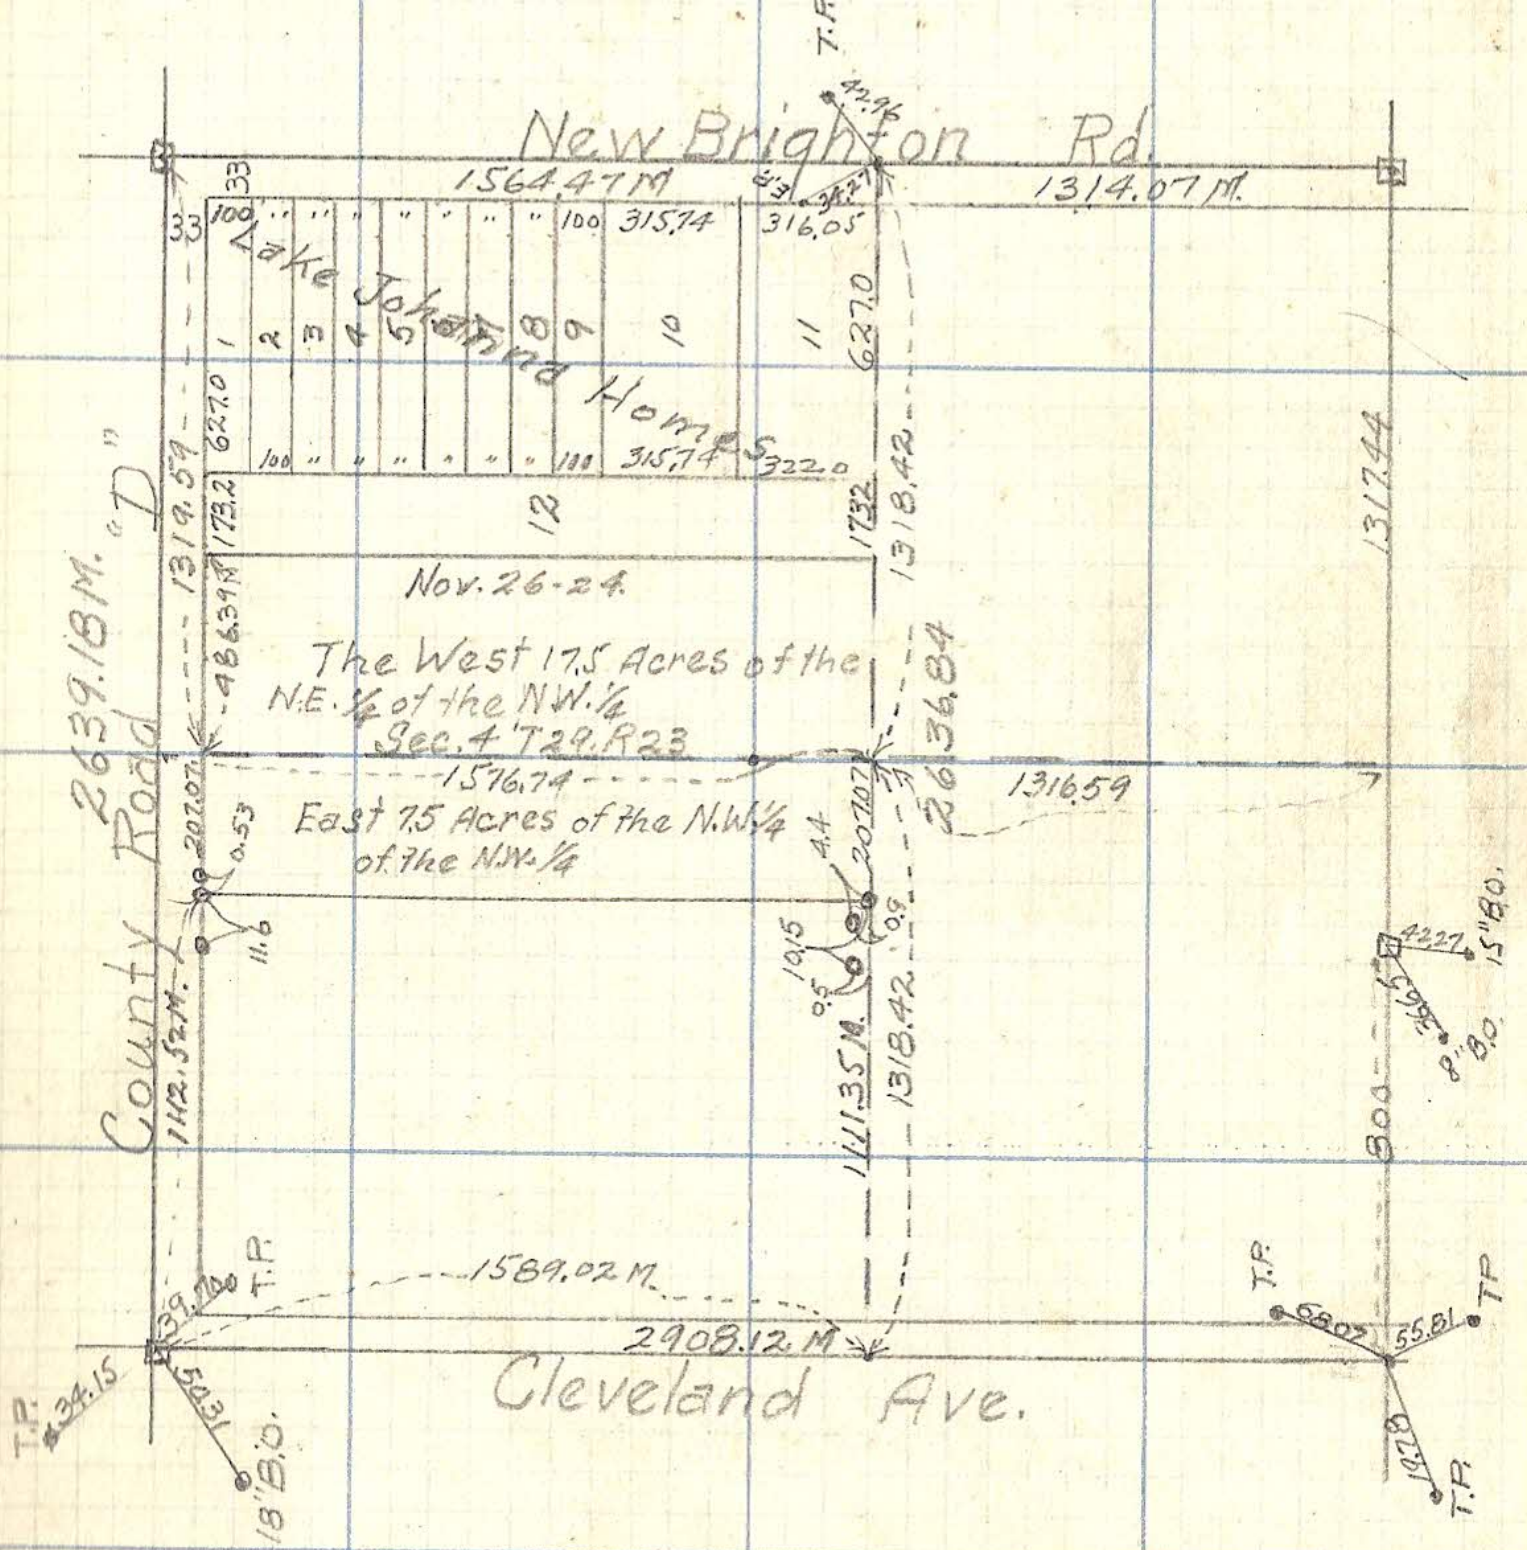
New Brighton Rd.
1564.47 M
1314.07 M.
Lake Johanna Homes
Nov. 26-24.
The West 17.5 Acres of the N.E. 1/4 of the N.W. 1/4
Sec. 4 T29. R23
East 7.5 Acres of the N.W. 1/4 of the N.W. 1/4
1576.74
1316.59
1318.42
1317.44
County Road "D"
2639.18 M.
1589.02 M.
2908.12 M
Cleveland Ave.
T.P.
18" B.O.
15" B.O.
8" B.O.