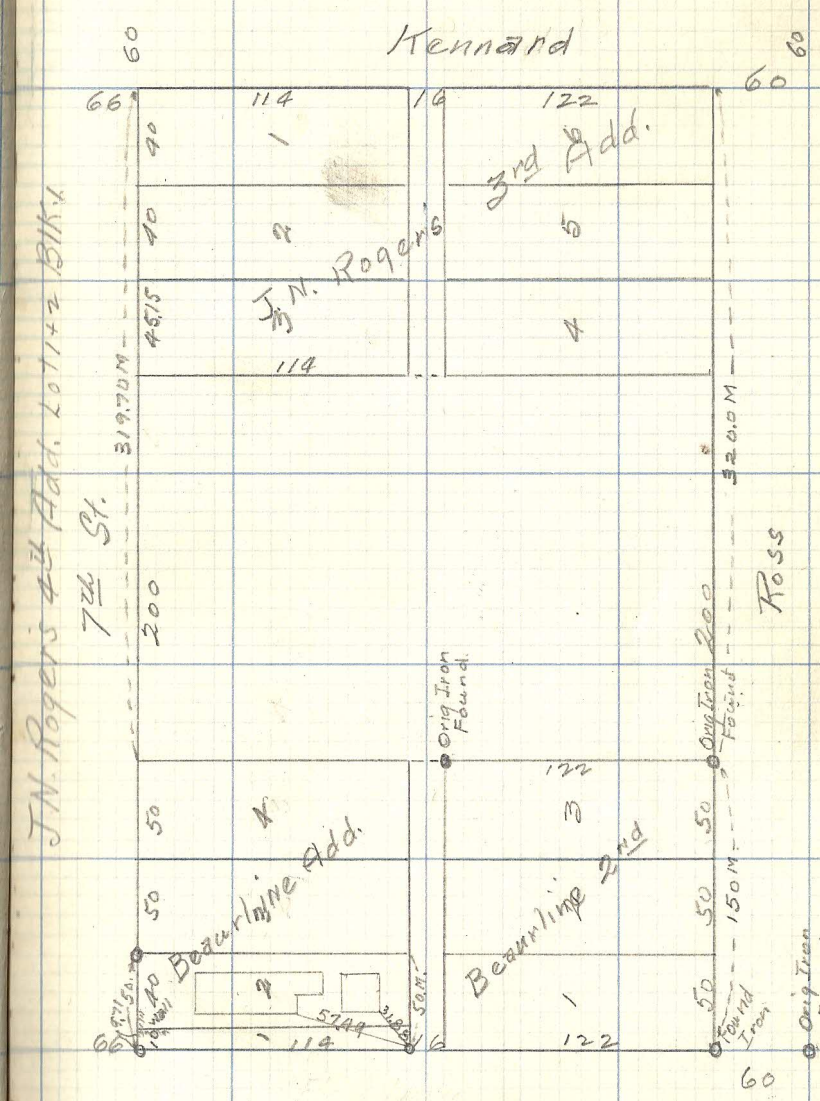
Kennard
60
60
60
66
114
16
122
40
1
3rd Add.
40
2
5
J.N. Rogers
45.15
4
114
319.70 M
320.0 M
7th St.
200
200
Ross
Orig Iron Found
Orig Iron Found
122
50
3
50
Beaurline Add.
Beaurline 2nd
50
50
150 M
40
2
1
50
50.M.
57.49
31.88
114
16
122
Found Iron
Orig Iron Found
60
J.N. Rogers 4th Add. Lot 1+2 Blk. 1