



L.C. & P.
650.33

26+32.91

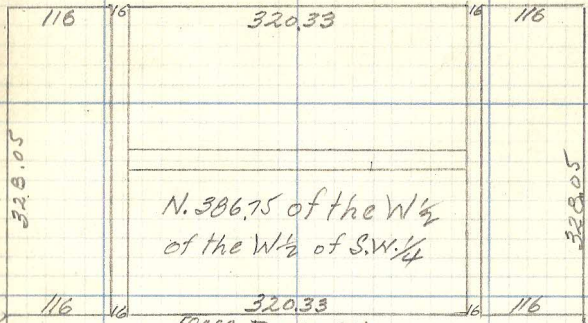

N. 386.75 of the W $\frac{1}{2}$
of the W $\frac{1}{2}$ of S.W. $\frac{1}{4}$

584.33 Denney

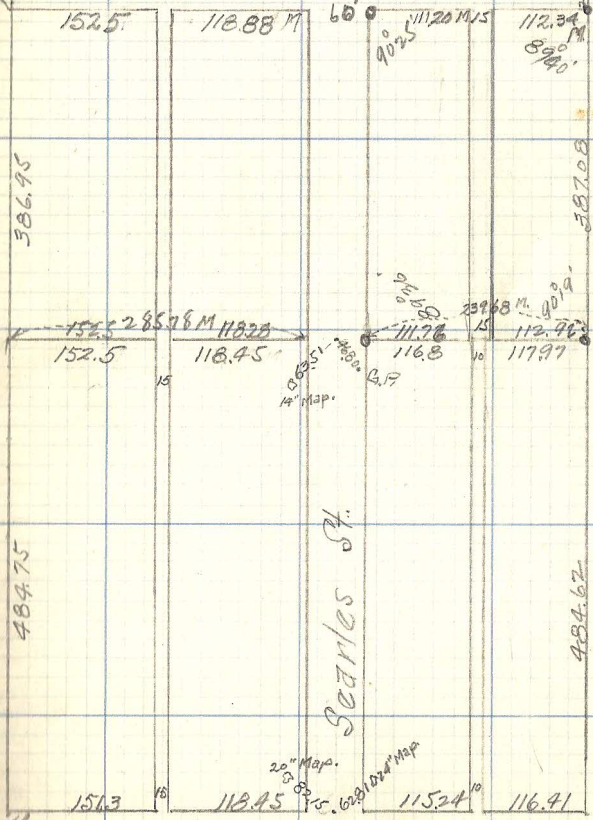

152.5

118.88 M

90° 25' 111.20 M 15

112.34 89° 40'

386.95

152.5

285.76 M 118.28

118.45

90° 25' 111.20 M 15

359° 58' M 100.9

111.26 116.8

112.96 117.97

484.75

15

14" Map.

Searles St.

484.62

156.3

118.95

115.24

116.41

Ivy

Egerton

Payne Ave

13+16.95
T.P.
B.P.

20" Map.
15. 6281 122" Map

386.95

577.75 M

T.P.

412.08

577.65

328.05

386.76

25.76

131636 Anna Manders S & A