

Lot 29-30 BIK 2

Heineman Shirk & Stierls Sub.

Heineman, Shirk & Stierls Sub Lot 29-30 BIK 2

4th St. E


White Bear Ave. No.

4159	40	15	127.33	20	127.23	4202	40
"	"	14					
"	"	13					
"	"	12					
"	"	11					
"	"	10					
"	"	9					
"	"	8					
"	"	7					
"	"	6					
"	"	5					
"	"	4					
"	"	3					
"	"	2					
"	"	1	127.16	20	127.16		

20

Flandrau St.

Sigel St.

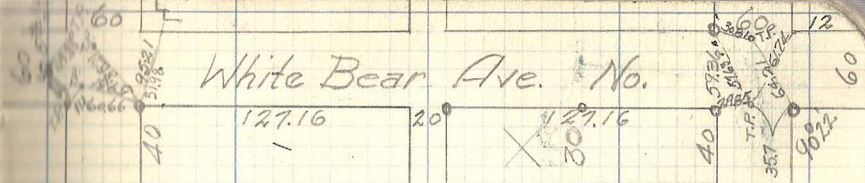

60