

2635.59

60

115.51

40
40


Buford Ave.
320.0 = R

400.6

80

St. Anthony Park North Lot 7-Block 66

Cleveland Ave.
320.0 = R

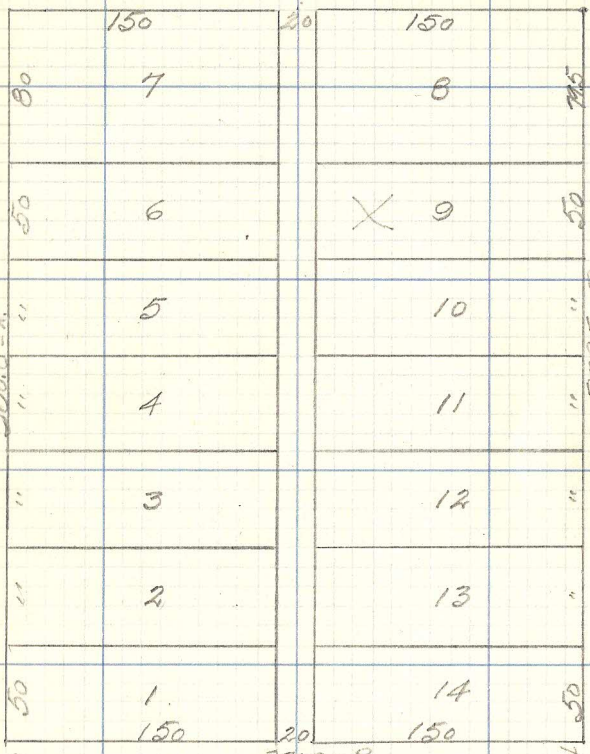

150
80
50
" 50
" 50
" 50
" 50
" 50
50

7
6
5
4
3
2
1

20
20

150
8
X 9
10
11
12
13
14

150
75
50
" 50
" 50
" 50
50

Raymond Ave.
379.5 = R

66

2119.82

Hendon Ave.

329.14

66