

AUERBACH & HAND'S ADD,
BLK. 20


15

33
30

OLIVER ST.

263.15M.

HAND
379.74 M.
295.0 M.
" "
" "
" "

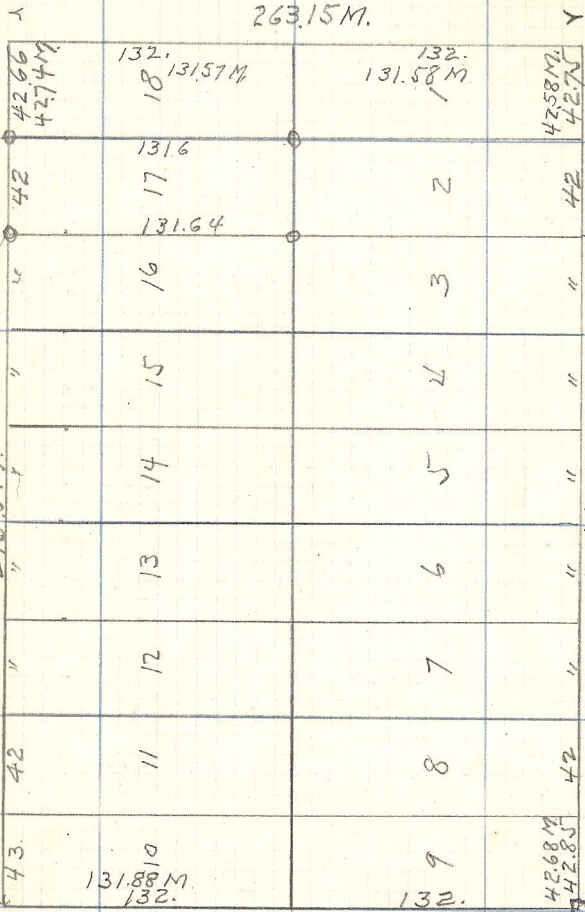

Ave.

Farrington

COOK ST.

263.76M.

30
35