CHARLES ST.

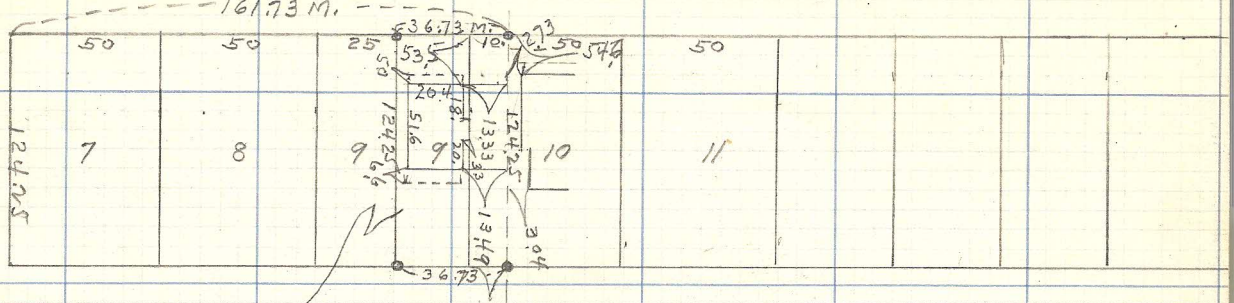

FARRINGTON AVE.

SHERBURNE AVE