


66

66

18

Hamline Ave.

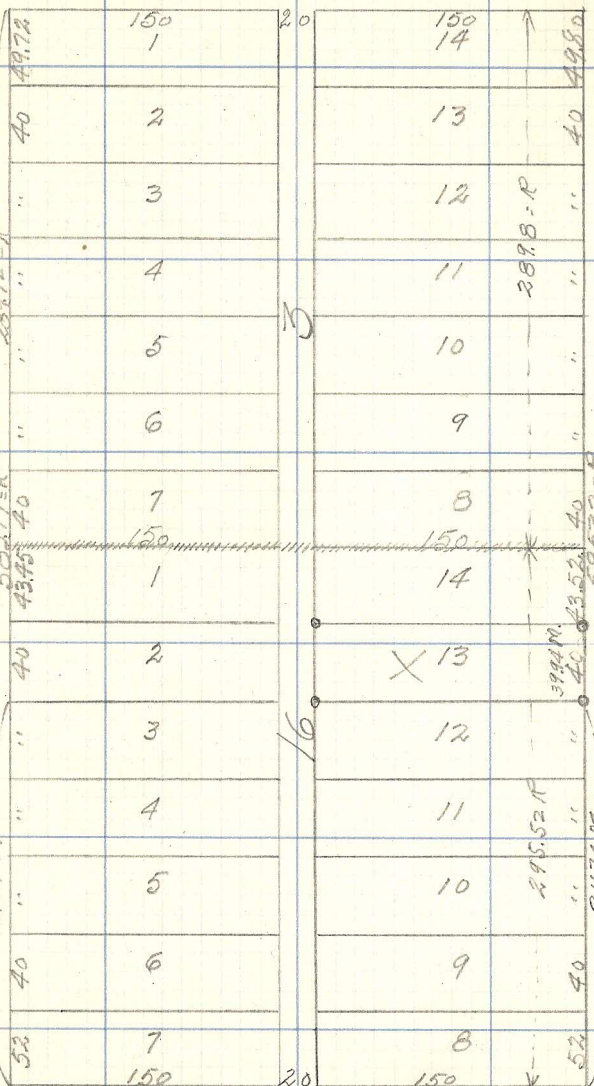

Albert Ave.

319.88 = M.

Lot 13 Bk 16 Boulevard Add. No. 2

Laurel Ave.

Ashland Ave.

70

70

60

60

66

66