


Feb. 14. 1925

John Gardner's  
Fourth Add.

20

Lot 12 & the So. 1/2 of Lot 14  
in Suburban Acre Lots.

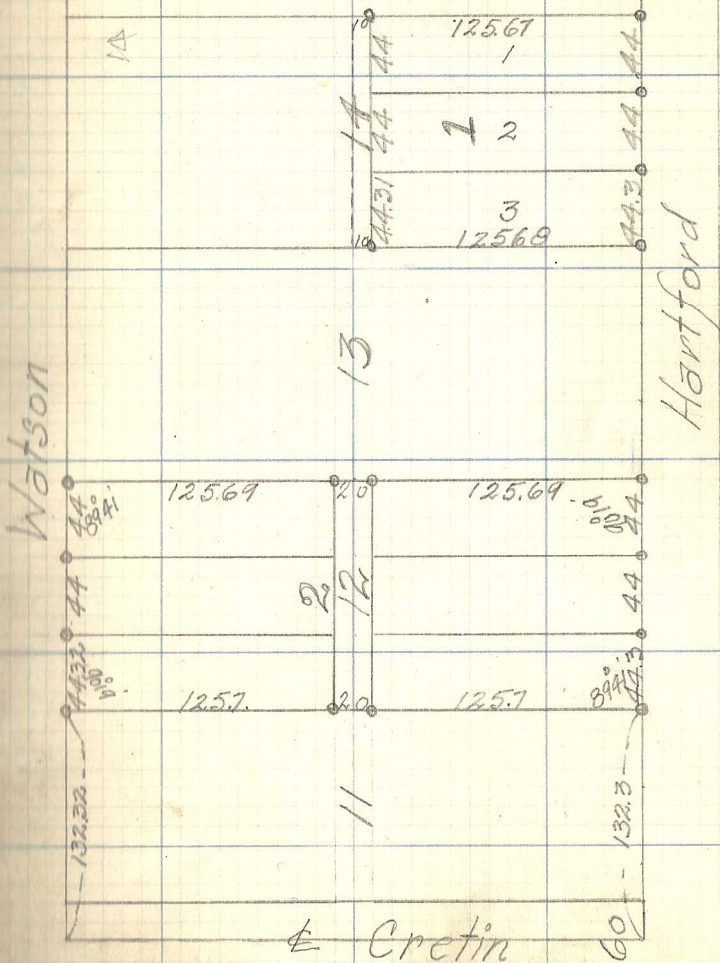

60

60