


66 Lot 4, Blk. 3 Homecroft Add. 66 22

Bellerue Ave. 123.95

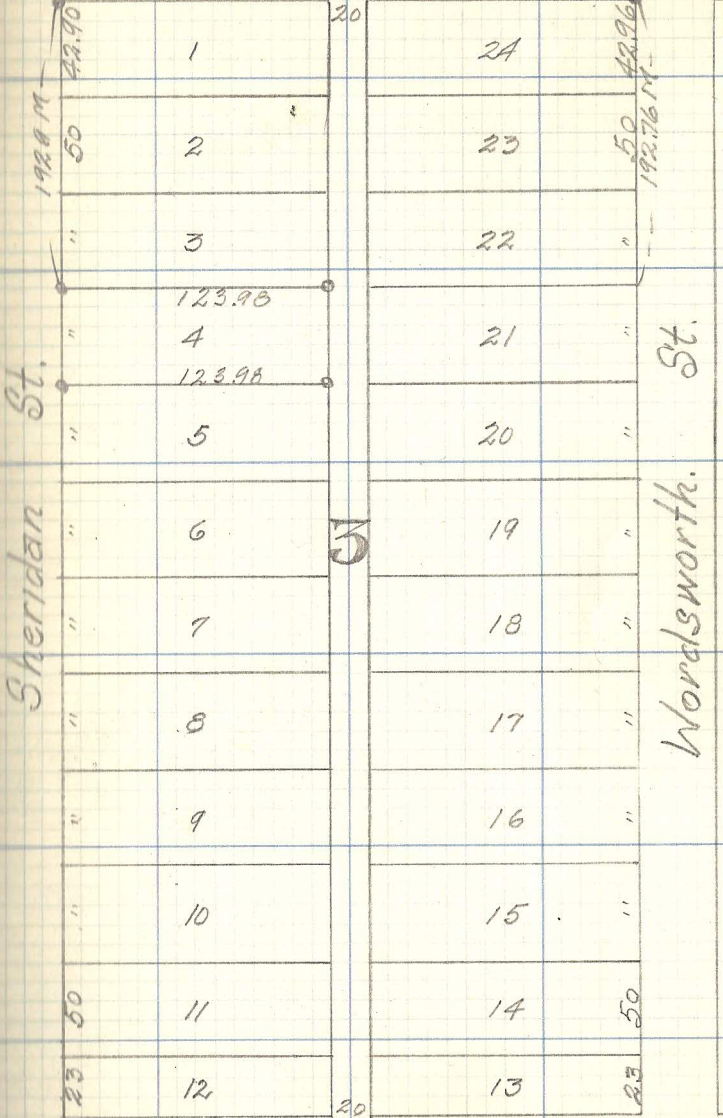

Edgecumbe Road.

66 66 120