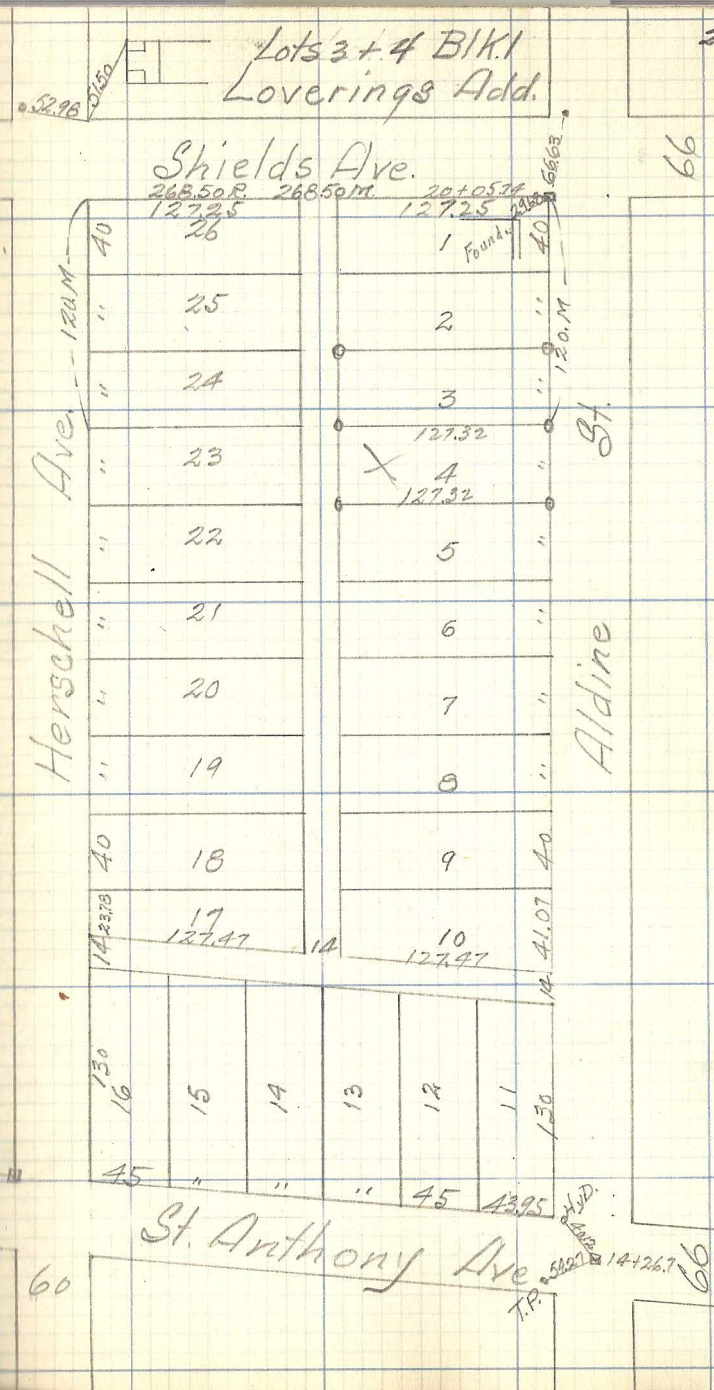
Lots 3 + 4 Blk. 1
Loverings Add.
52.98
51.50
Shields Ave.
268.50 R.
268.50 M.
20+05.74
127.25
127.25
66.63
29.68
Found.
Herschell Ave.
Aldine St.
120 M
120 M
40
26
25
24
23
22
21
20
19
18
17
127.47
14
1
2
3
4
5
6
7
8
9
10
127.32
127.32
40
40
40
41.07
14
23.78
14
130
16
15
14
13
12
11
130
45
45
43.95
St. Anthony Ave.
60
66
HyD.
40.12
54.27
14+26.7
T.P.