


60 Lot 23 Blk 7 J.A. & W.M. Steers Add. 66 26

Earl 7 1/2 St. 60

Hawthorne St.

St.

Maryland.

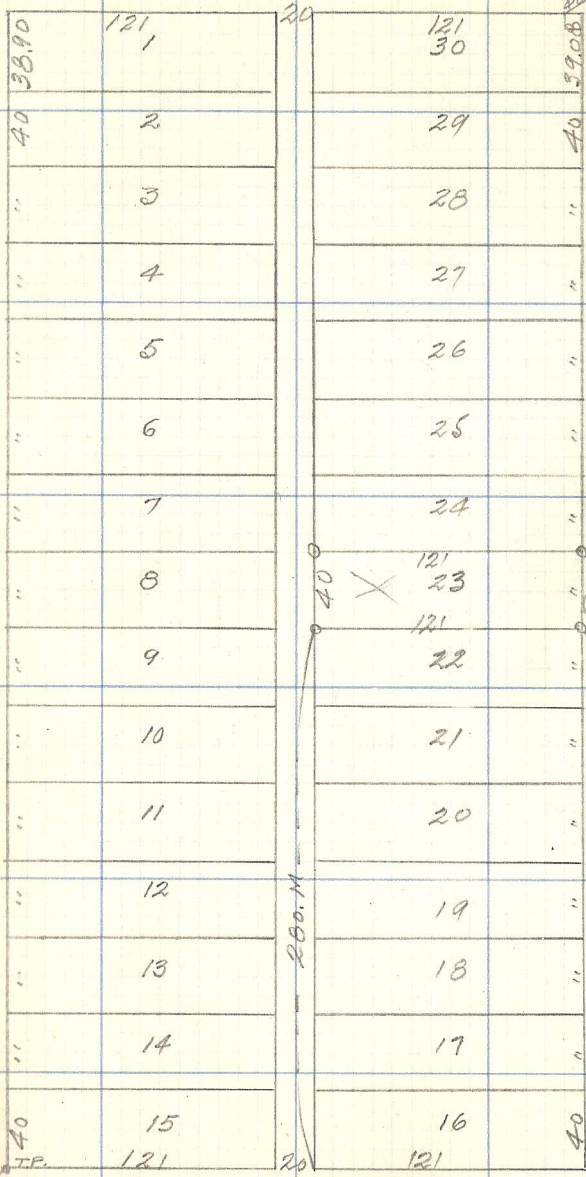

Cypress St.

66

60

66