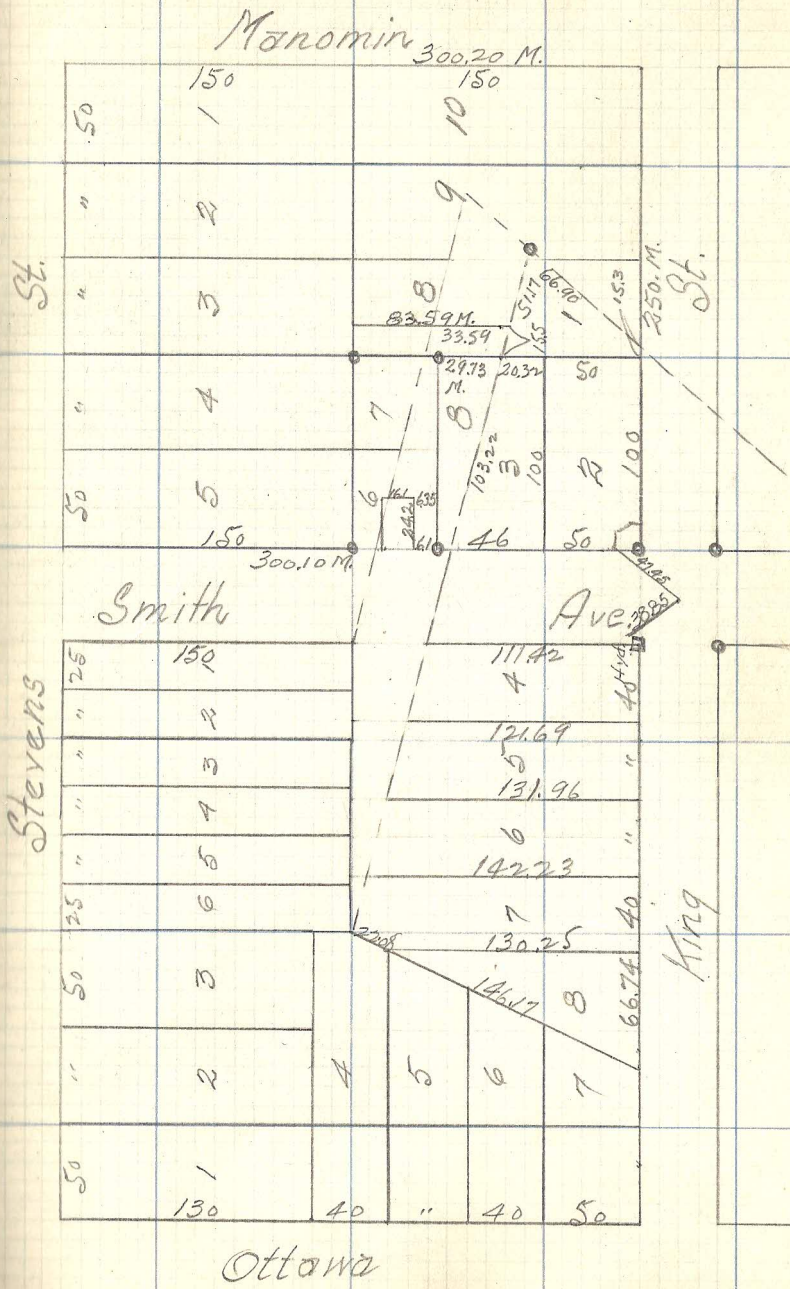60 Lot 6 & 7 Olivers Add Blk 19. 60 27