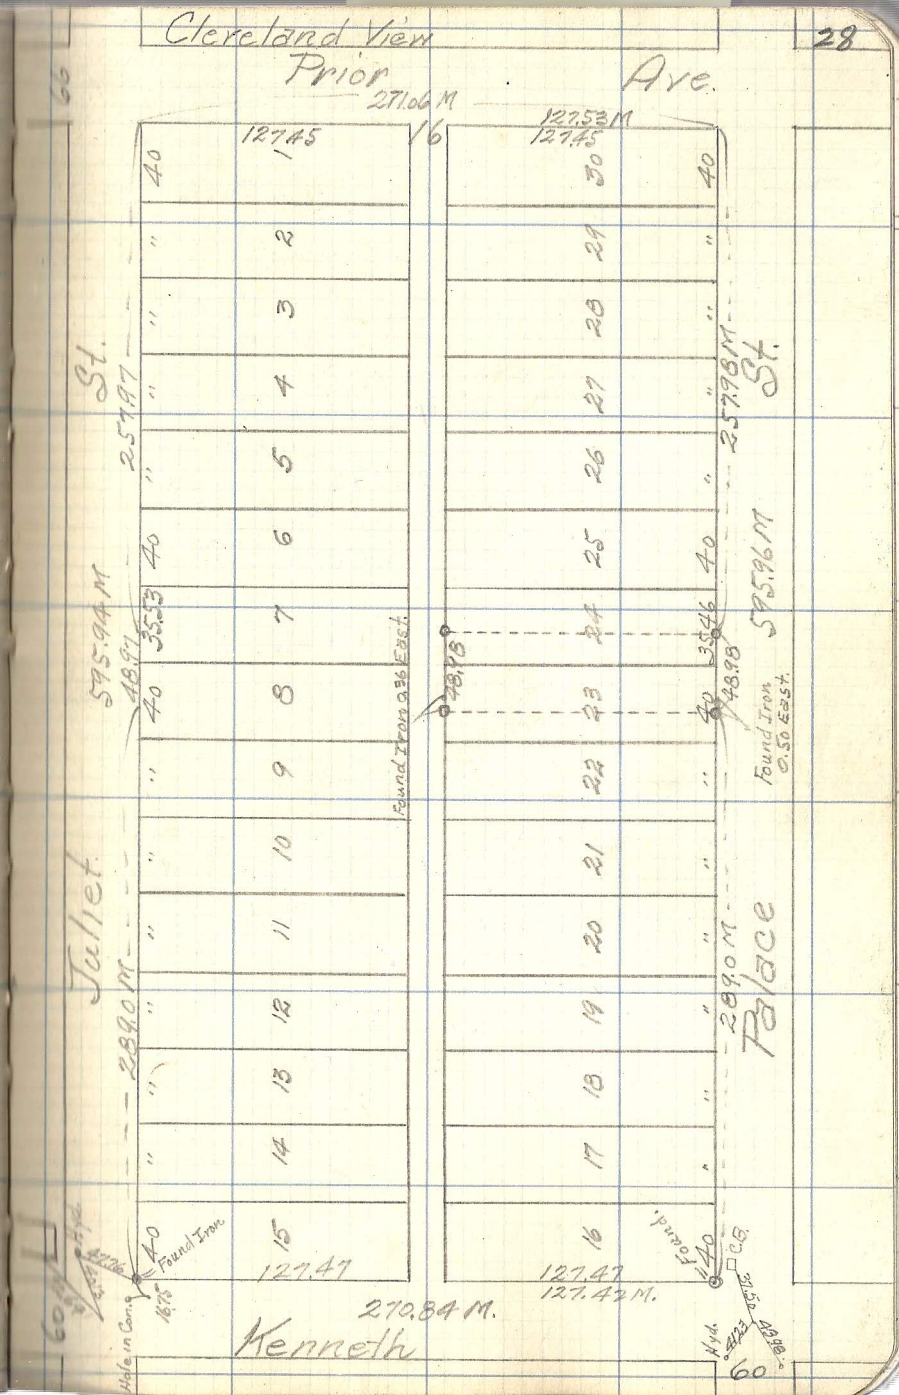
Cleveland View
Prior Ave.
271.06 M
127.45
127.53 M
127.45
16
Juliet St.
Palace St.
Kenneth
595.94 M
48.97
35.53
257.97
289.0 M
Found Iron 0.36 East
48.98
Found Iron 0.50 East
35.46
48.98
257.98 M
595.96 M
289.0 M
Found Iron
Hole in Con.
16.75
127.47
127.47
127.42 M.
270.84 M.
Found.
C.B.
Hyd.
60