
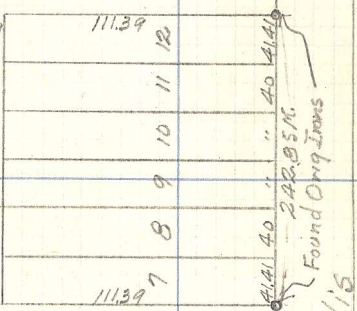


Oakdale Ave

Lot 6 (Blk.) Cushings Add.

St E

St E

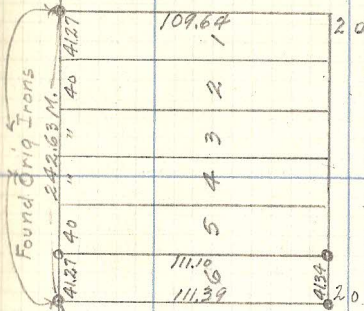

Wyoming

Annapolis

Robert St.

60
45.72
32.52
32.52
T.P.
C.O.B.

60
29

60
33.38
31.72
T.P.

60
80