

Maryland

Lot 14 BIK. 2.

Brainerd Ave.

St. 50

Clark


Arkwright

66

60

60

Jayward Add. Lot 14 BIK. 2.

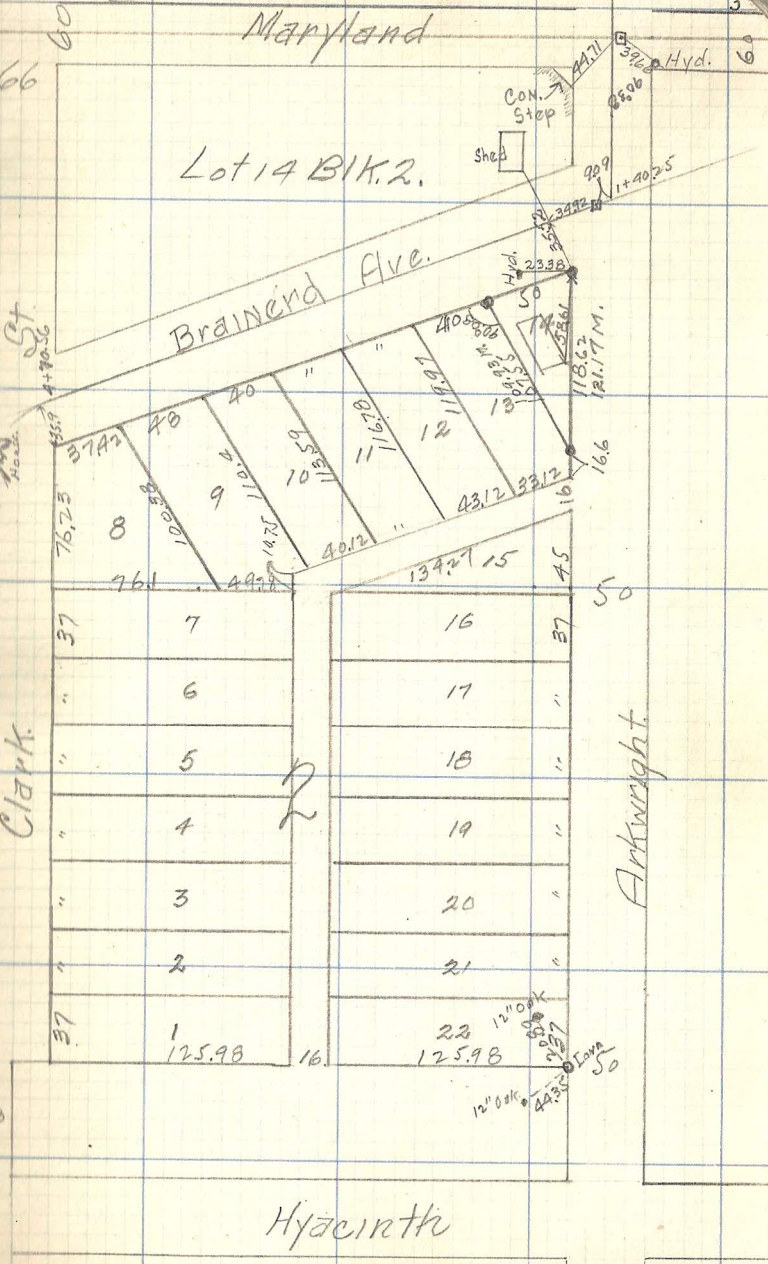

CON. Step

Shed

Hyd.

Hyd.

2

50

12" Oak

12" Oak

50

Hyacinthe

33