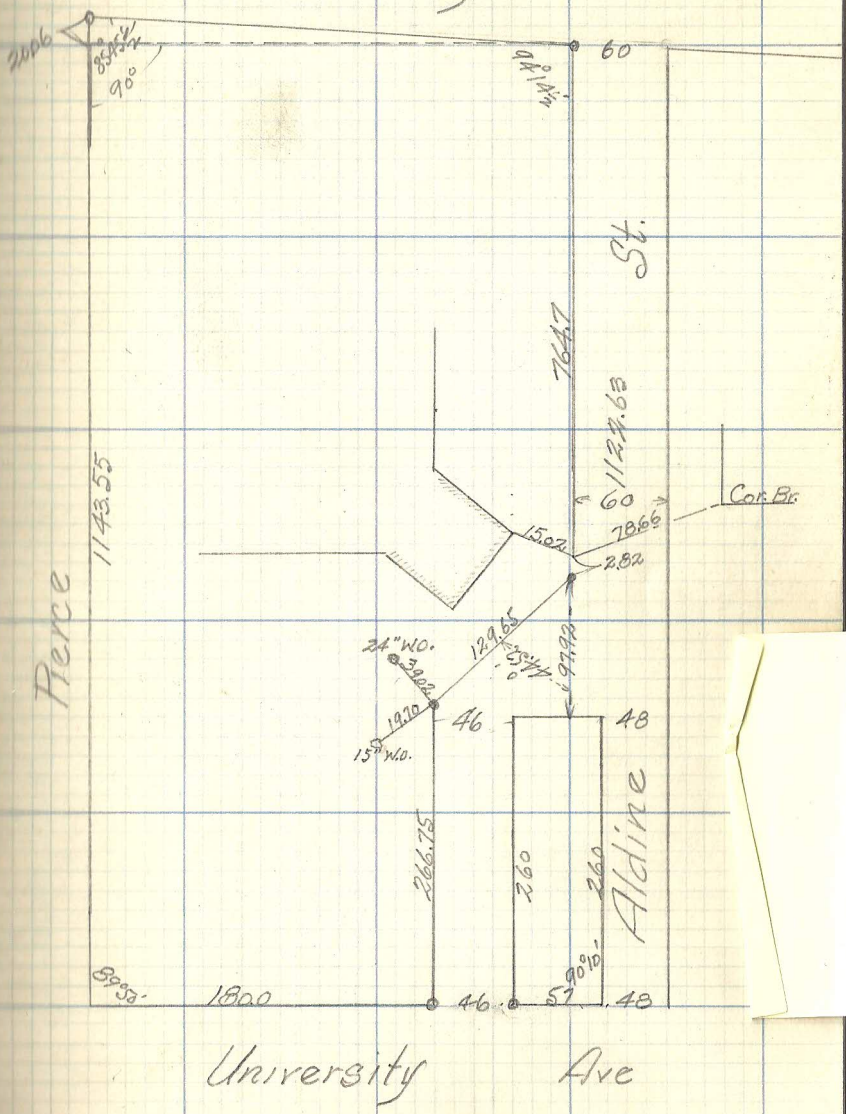Midway Hospital
St Anthony