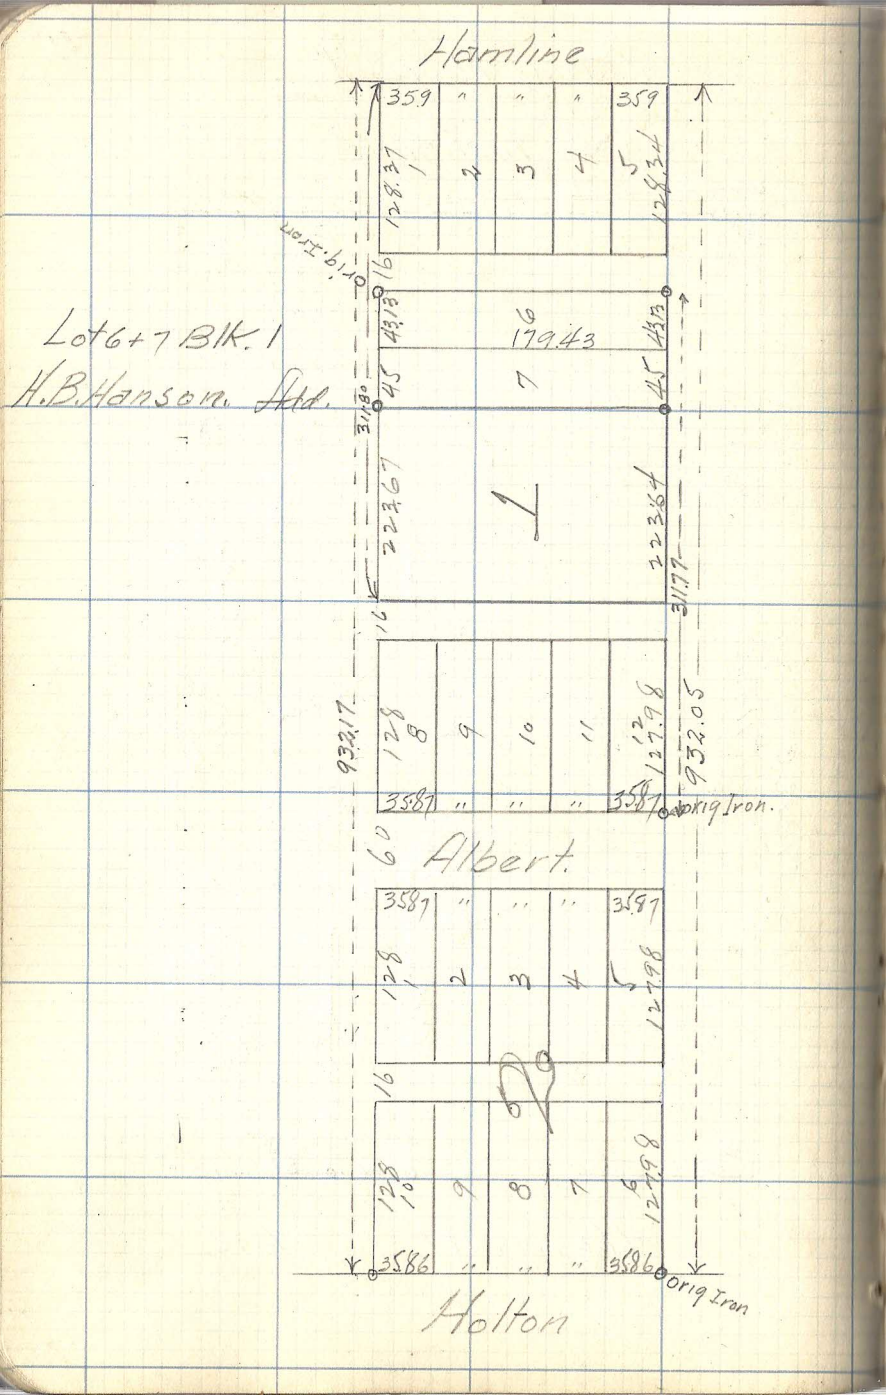
Hamline
Lot 6+7 Blk. 1
H.B. Hanson Add.
Albert
Holton
Orig Iron

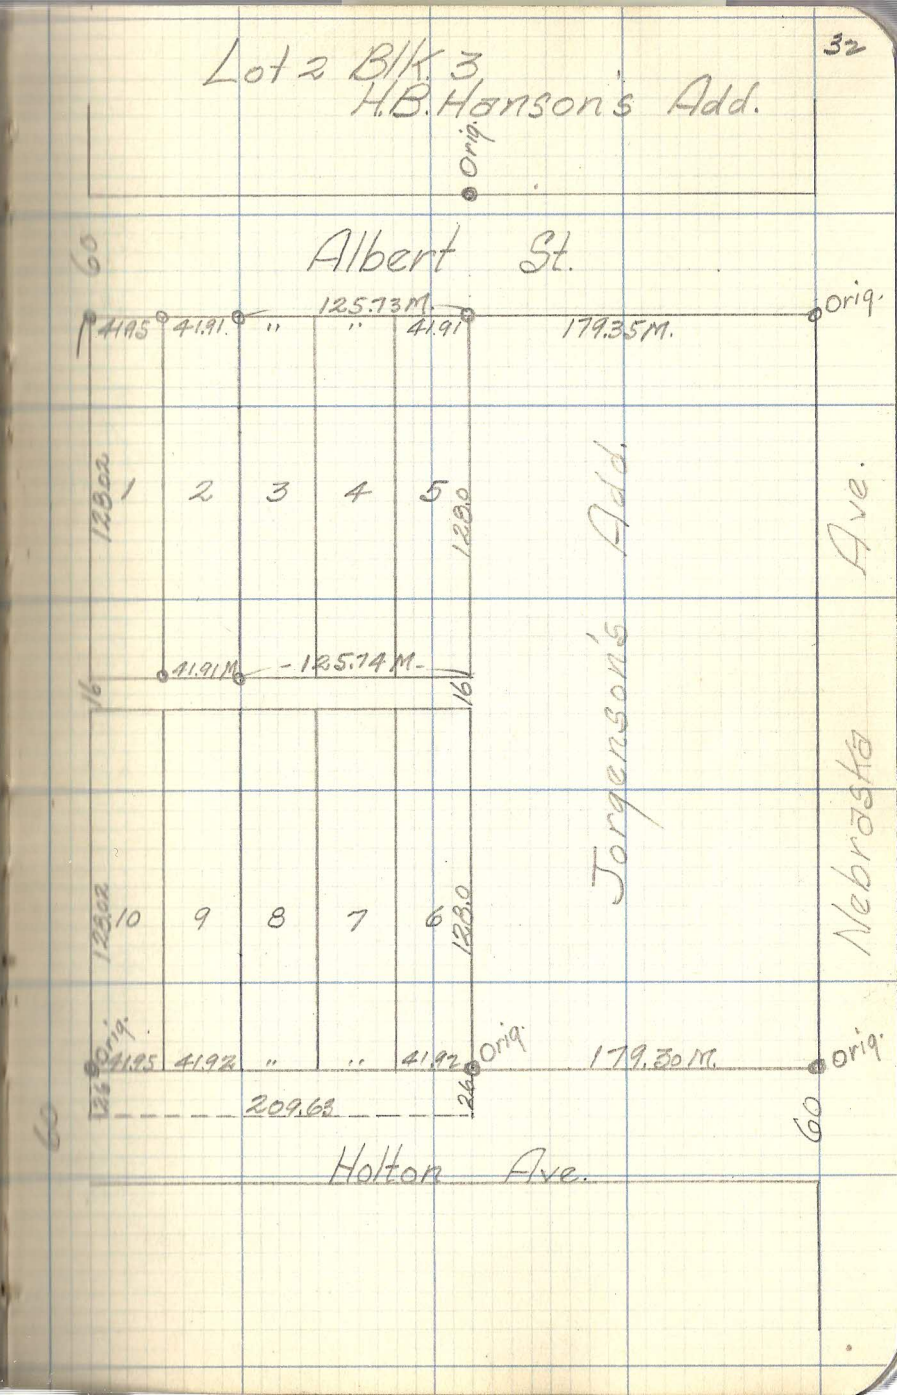
Lot 2 Blk. 3
H.B. Hanson's Add.
Albert St.
Jorgenson's Add.
Nebraska Ave.
Holton Ave.
Orig.