Aug. 1 - 25

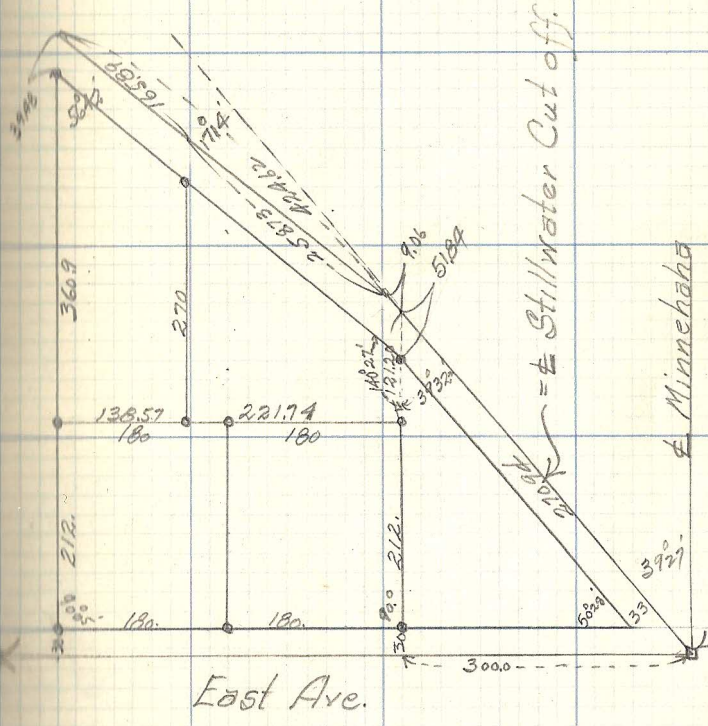
East Ave.
300.0
180.
180.
212.
212.
360.9
270
138.57
180
221.74
180
165.69
2578
2484.62
9.06
51.84
1802.74
1212.74
37°33'
210.44
39°27'
50°33'
33
= ℄ St. // Water Cut off.
℄ Minnehaha
= S.W. Cor. Sec. 25 T29 R23.