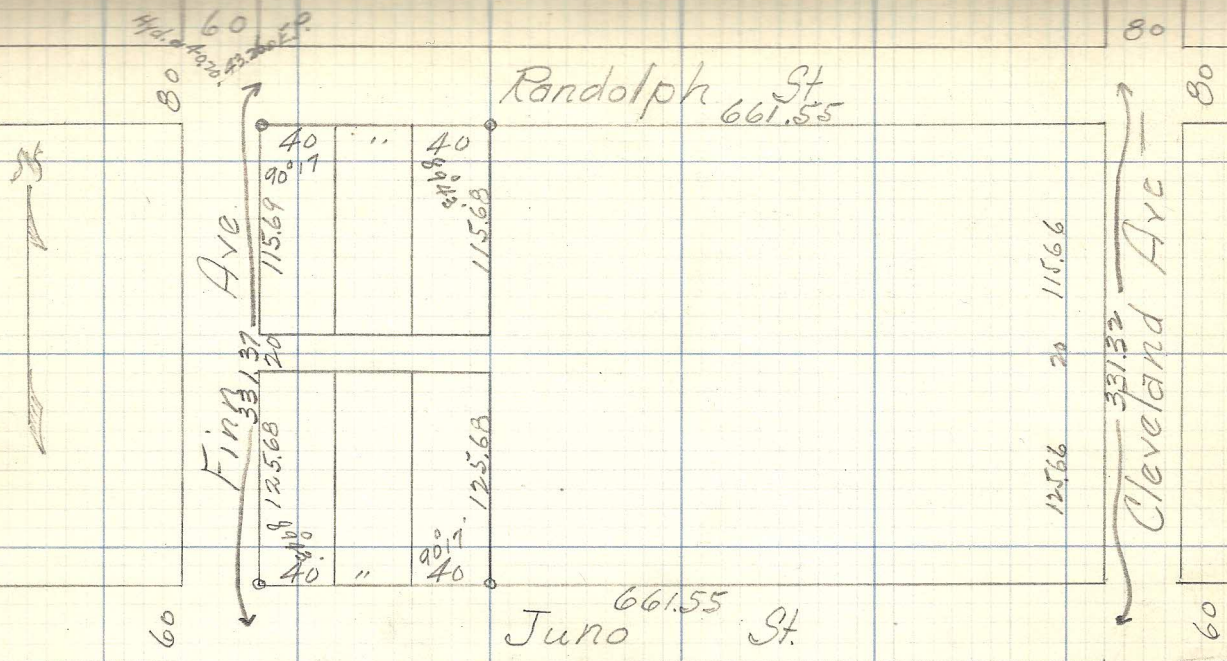

The W. 150 ft. of E½ of No. ½ of N.E. ¼ of S.E. ¼
Sec. 8-28-23

75