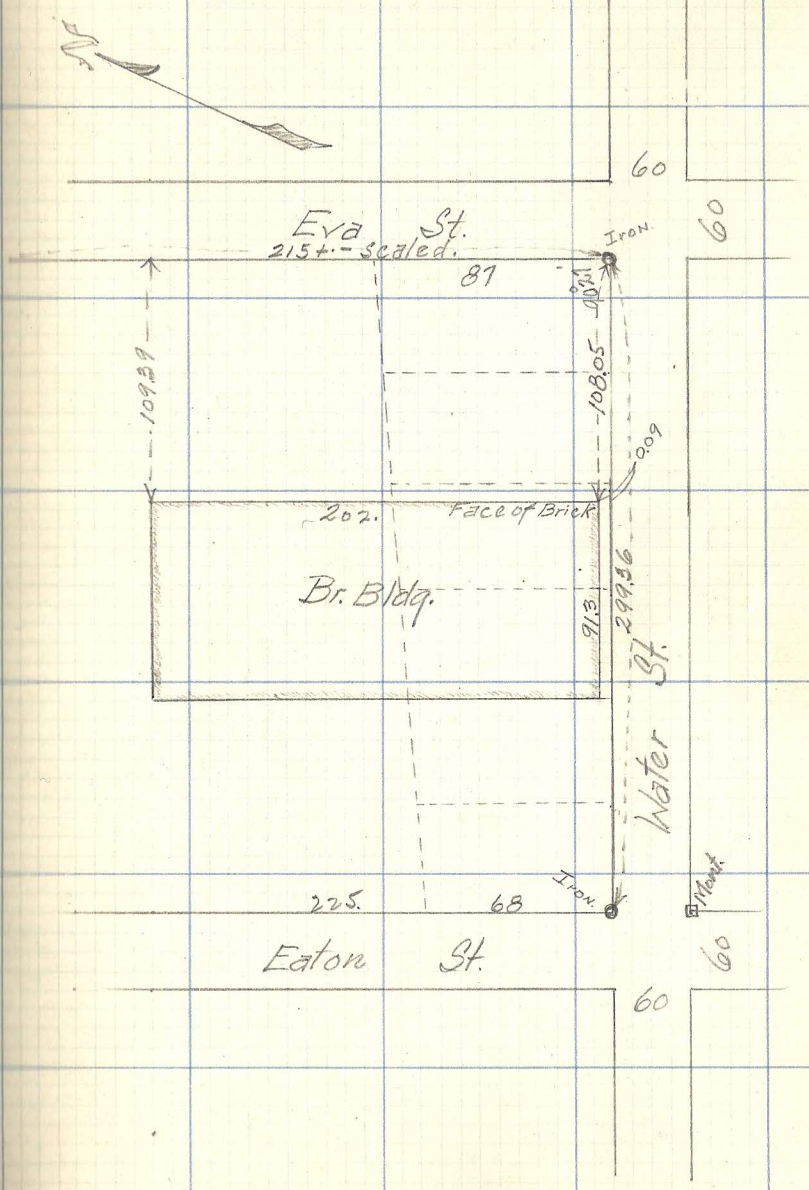West side Levy
Am. Hoist & Derrick Co.