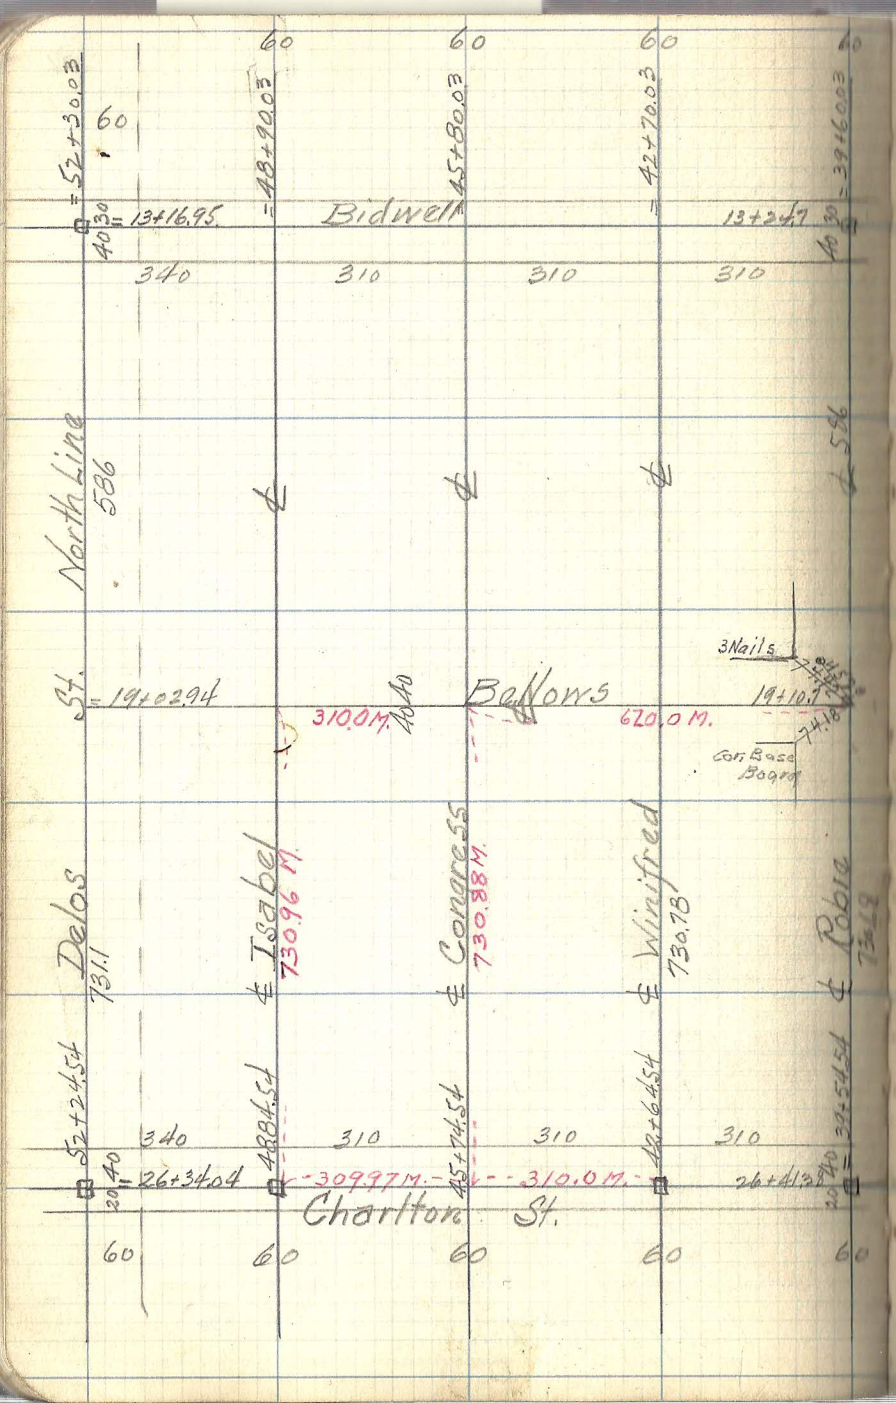
Bidwell
Bellows
Charlton St.
North Line
St.
Delos
Isabel
Congress
Winifred
Robie
3 Nails
Con Base Bogey
310.0 M.
620.0 M.
730.96 M.
730.88 M.
730.78
731.1
731.2
-19+02.94
19+10.1
-26+34.04
-30997 M.
-310.0 M.
340
310
586
40
60

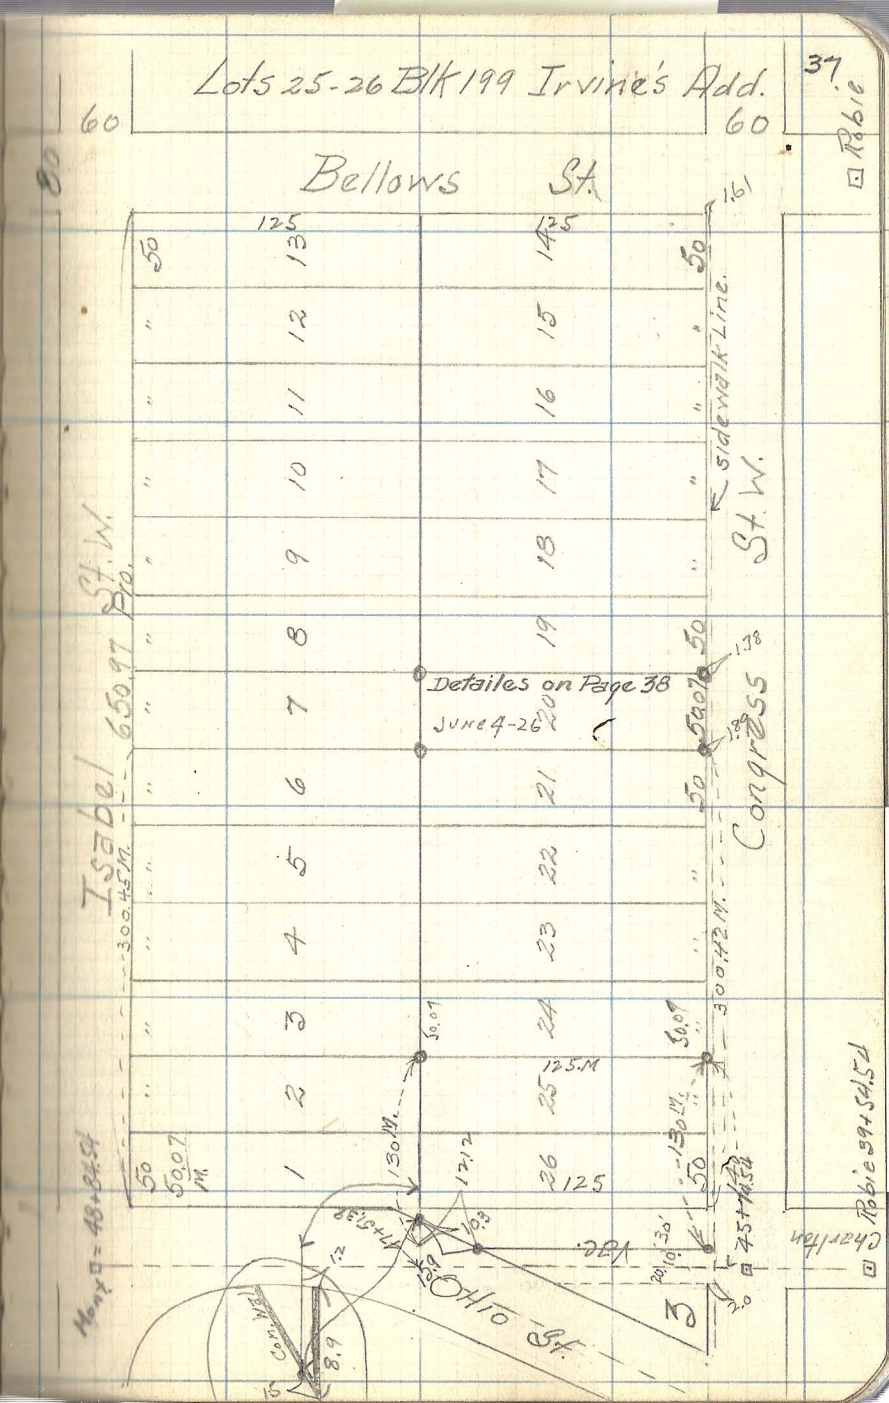
Lots 25-26 Blk 199 Irvine's Add.
37.
R&16
Bellows St.
St. W.
Isabel
Congress
Robie
Charlton
Ohio St.
Detailes on Page 38
June 4-26
sidewalk Line.
650.97
300.45 M.
300.42 M.
125
125.M
50
50.07
30.07
130 M.
121.2
103
20.10.30'
3.0
8.9
Con. Wall
1.2
1.78
1.89
1.38