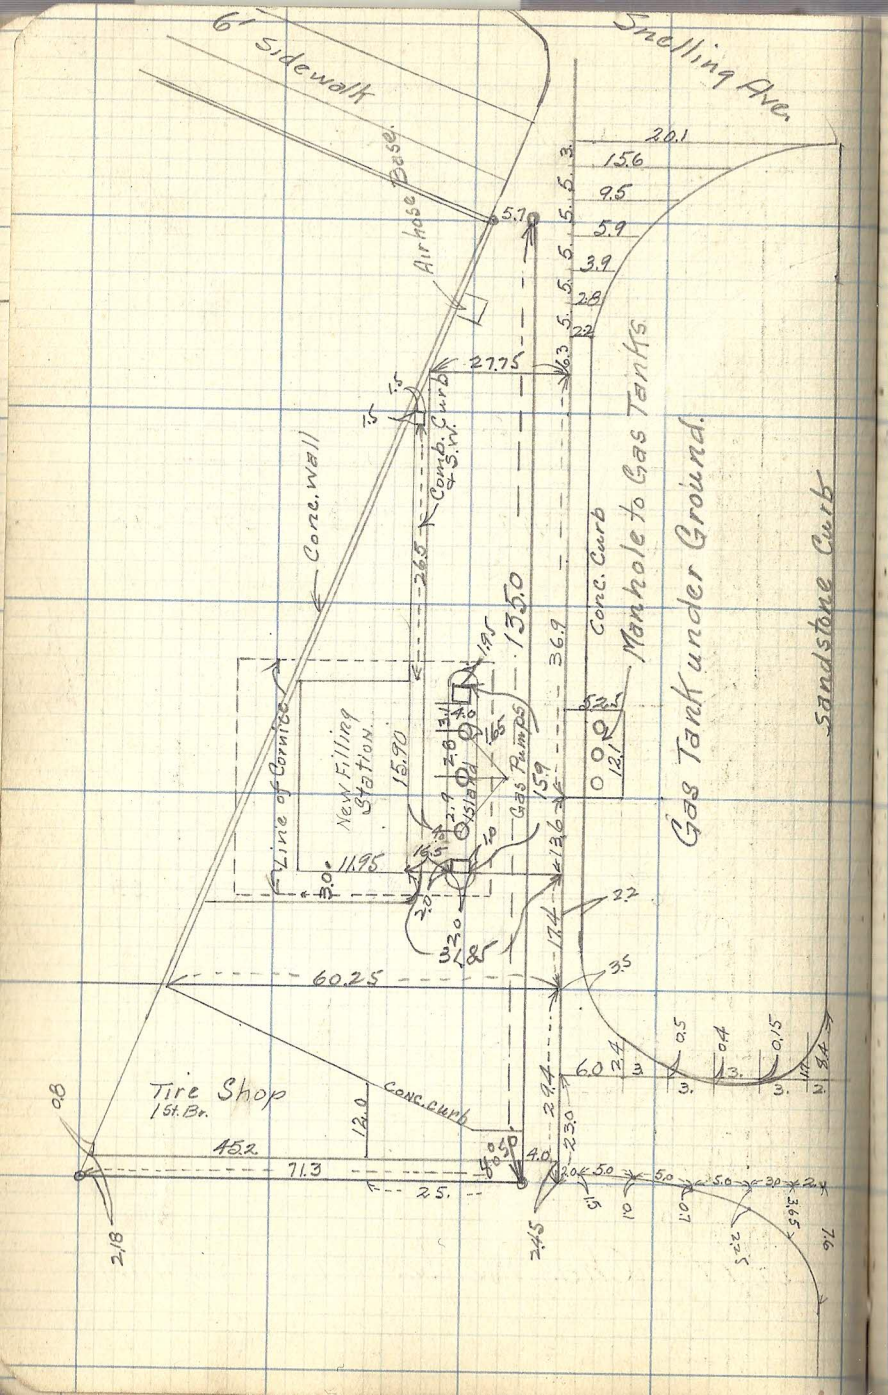
6' Sidewalk
Snelling Ave.
Air Hose Base
Conc. Wall
Conc. Curb & Sw.
New Filling Station
Island
Gas Pumps
Conc. Curb
Manhole to Gas Tanks
Gas Tank under Ground.
Sandstone Curb
Tire Shop
1st. Br.
Conc. Curb
60.25
71.3
25.
27.75
135.50
15.90
11.95
20.1
15.6
9.5
5.9
3.9
2.8
2.2
36.9
52.5
12.1
60.2
23.0
40.0
2.18
2.45

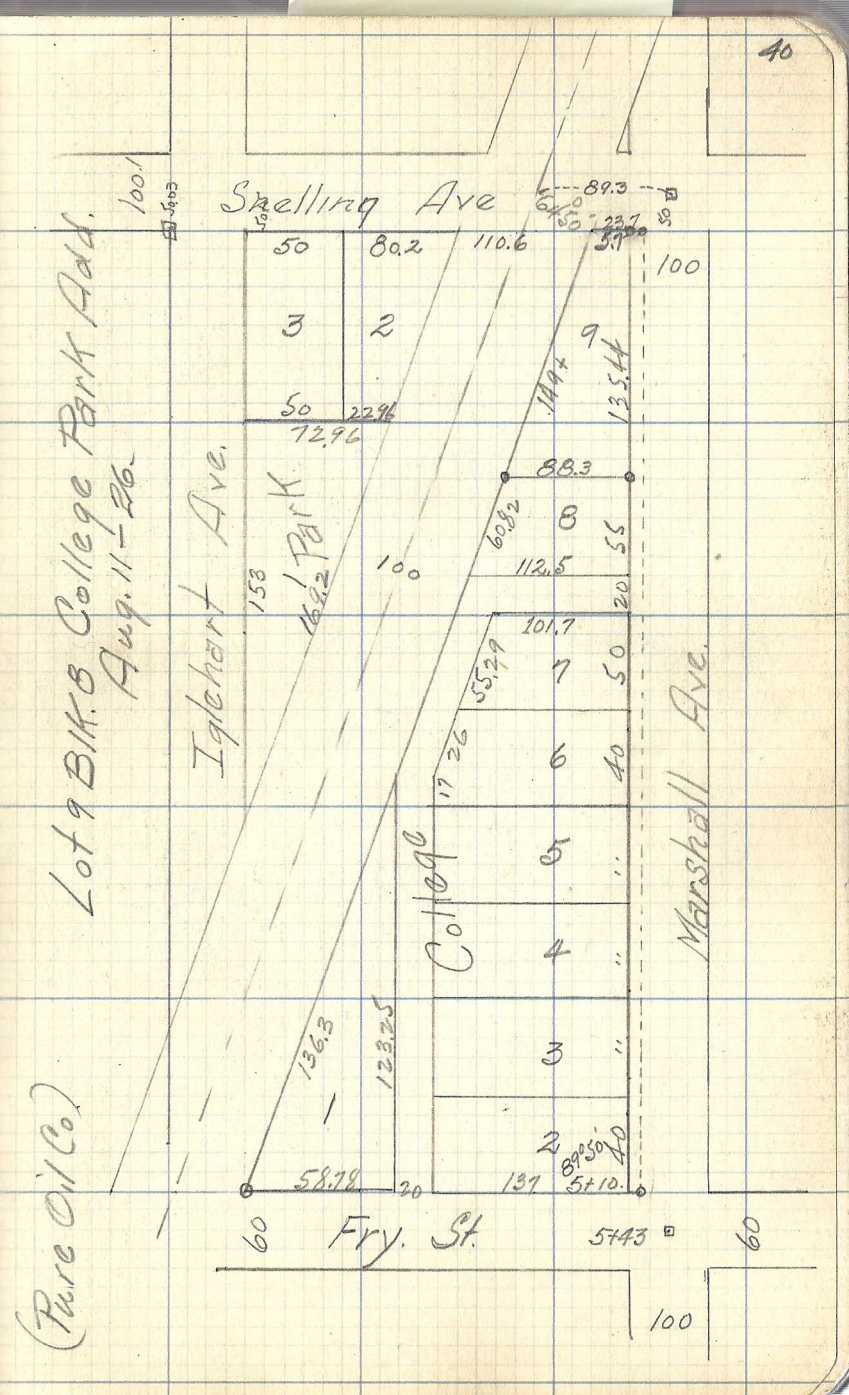
Snelling Ave
Lot 9 Blk. 8 College Park Add.
Aug. 11 - 26.
Iglehart Ave.
College Park
College
Marshall Ave.
(Pure Oil Co.)
Fry. St.
5743
50
80.2
110.6
3
2
72.96
22.96
144.4
135.44
88.3
8
112.5
101.7
7
6
5
4
3
2
1
136.3
123.25
58.78
89.50
137
5+10.
60
100