


60

Baldwin

Summit Ave.

Grand Ave

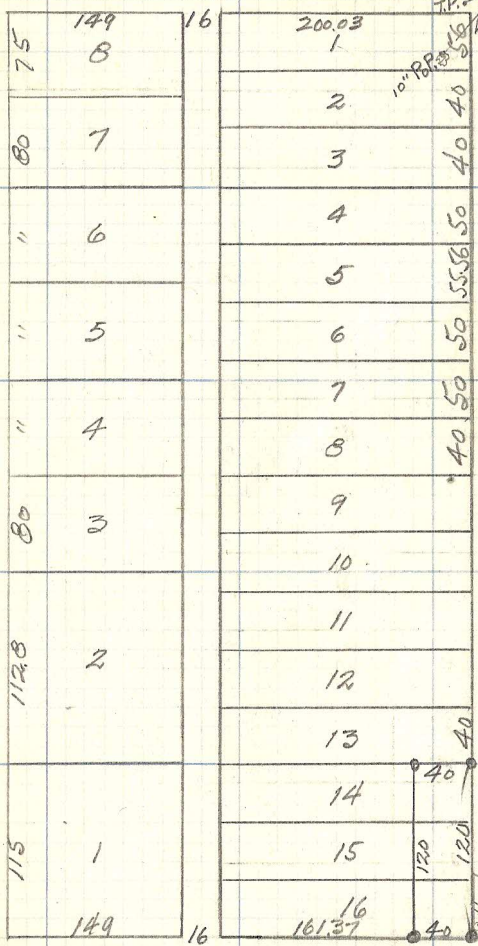

80
 9 Hyd.
 74.33286
 47.34
 10" P.P. 16
 78.85

66

Fairview Ave

South 40ft. of Lots 14-15-16
 Elmer & Morrisons Re. Ar.

80

