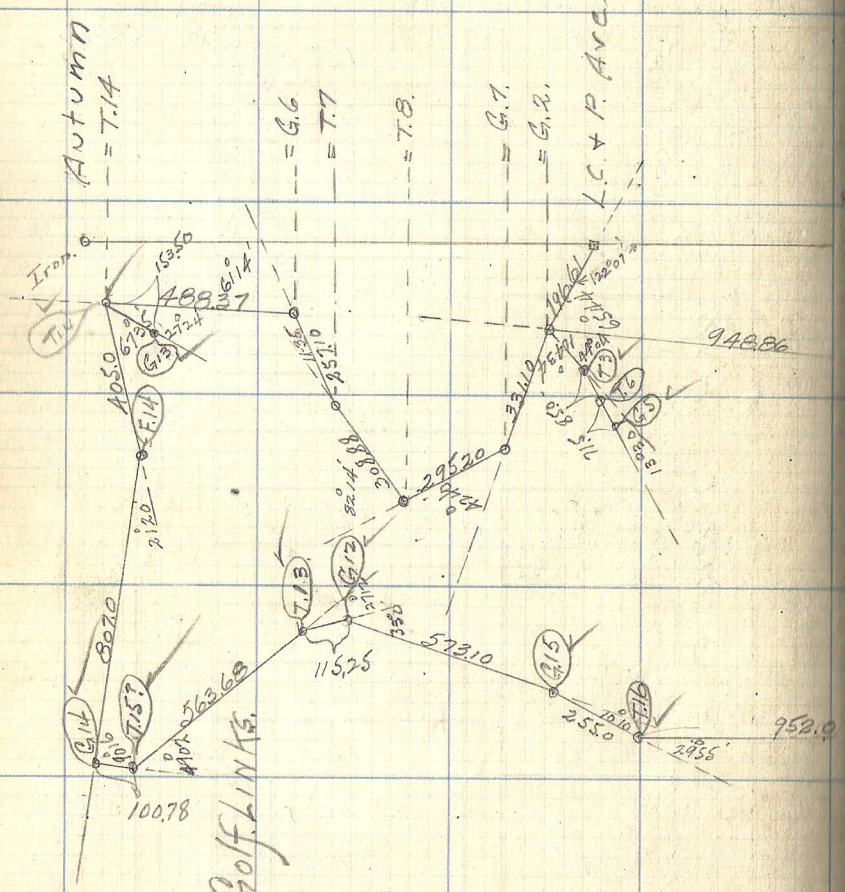
Autumn
= T.14
= G.6
= T.7
= T.8.
= G.1.
= G.2.
L.C.+P. Ave.
Iron
948.86
952.0
Hillcrest Golf Links

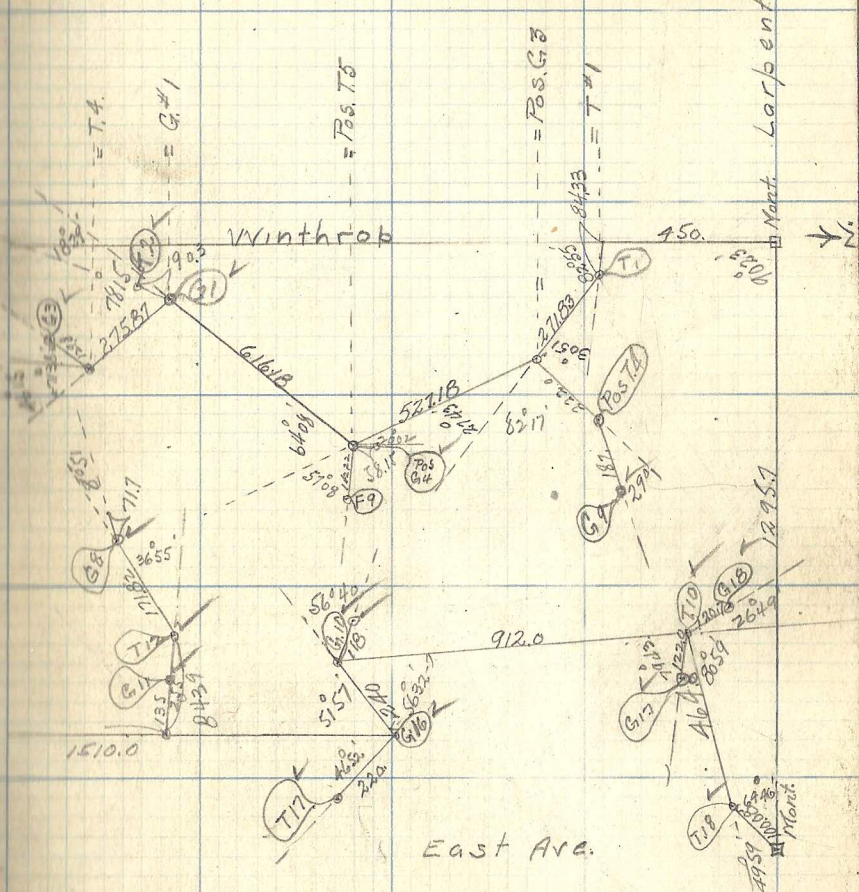
Winthrop
= T.4.
= G.#1
= Pos. T5
= Pos. G8
= T.#1
Mont Larbentear
450.
912.0
1610.0
East Ave.
Mont.