

66


66

Wheeler Ave

Carroll Ave

Iglehart Ave

Lots B, K, B, Lovering Park

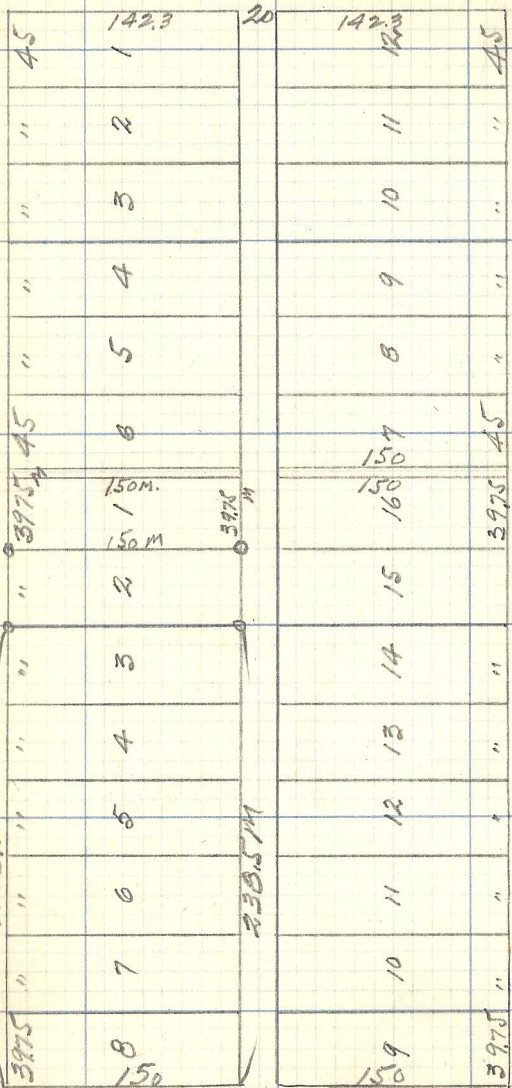

Fairview Ave

66
2975
207

3975
2968