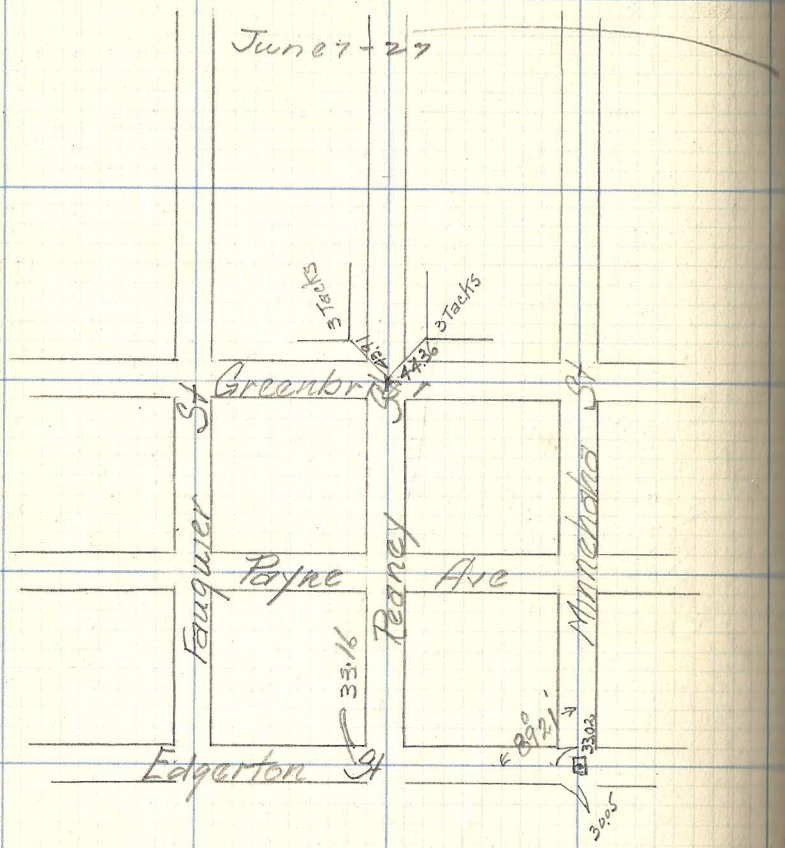

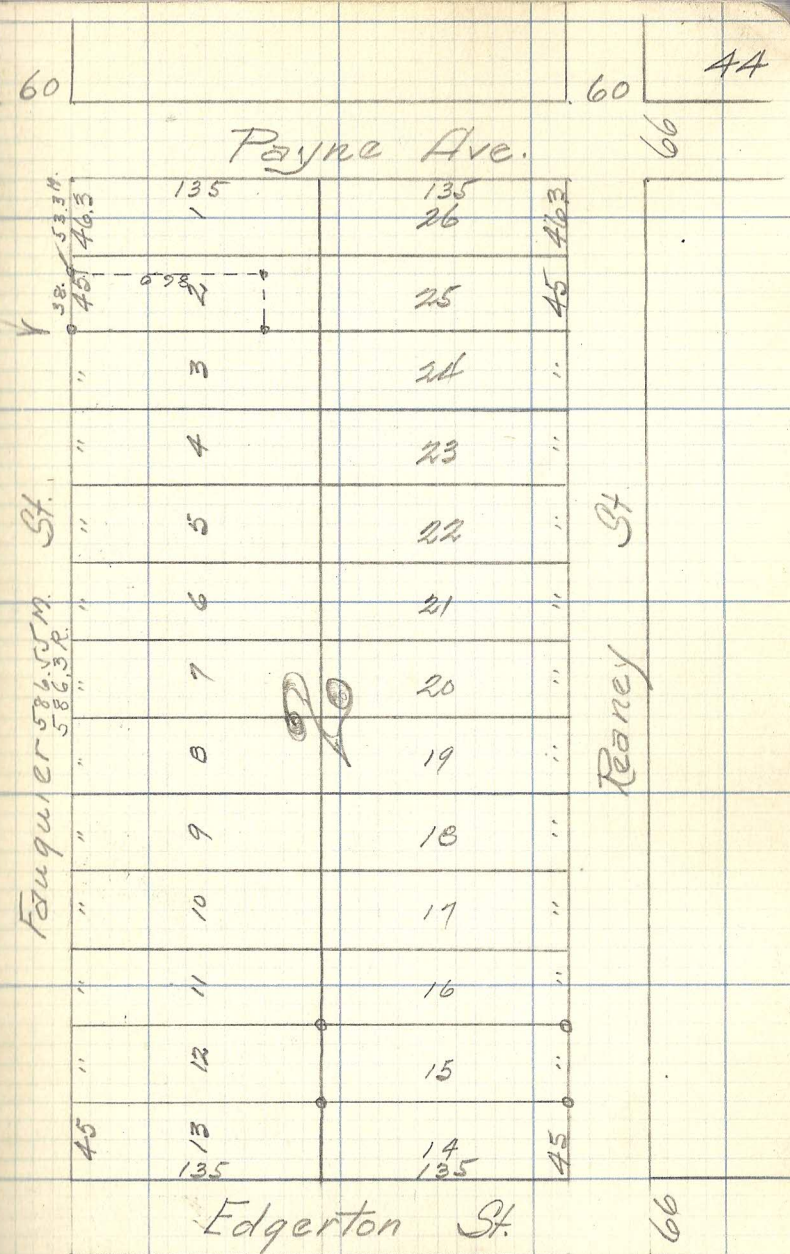

Lot 15 Blk 2 & 15
Borup & Payne's Add.