
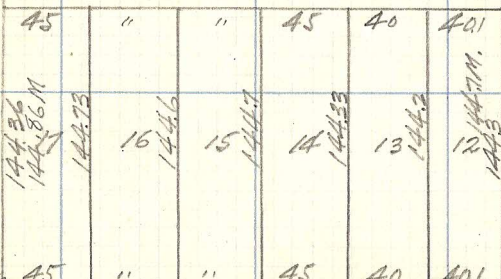


Ione  
260.4 R

Malvern  
596.86 M

EUSTIS  
596.07 M

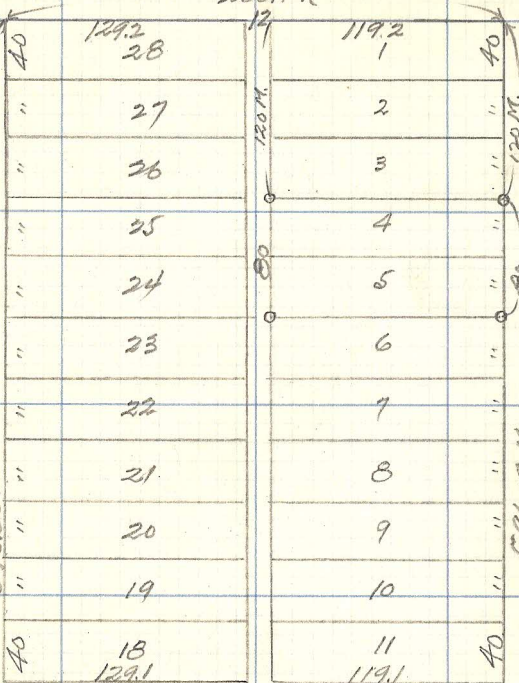

260.11 M  
Larpentuer Ave

Lots 4+5

37.250 Store.

66

286.2  
18.7  
70

Bank  
Mar  
66

92.23

600

82.53