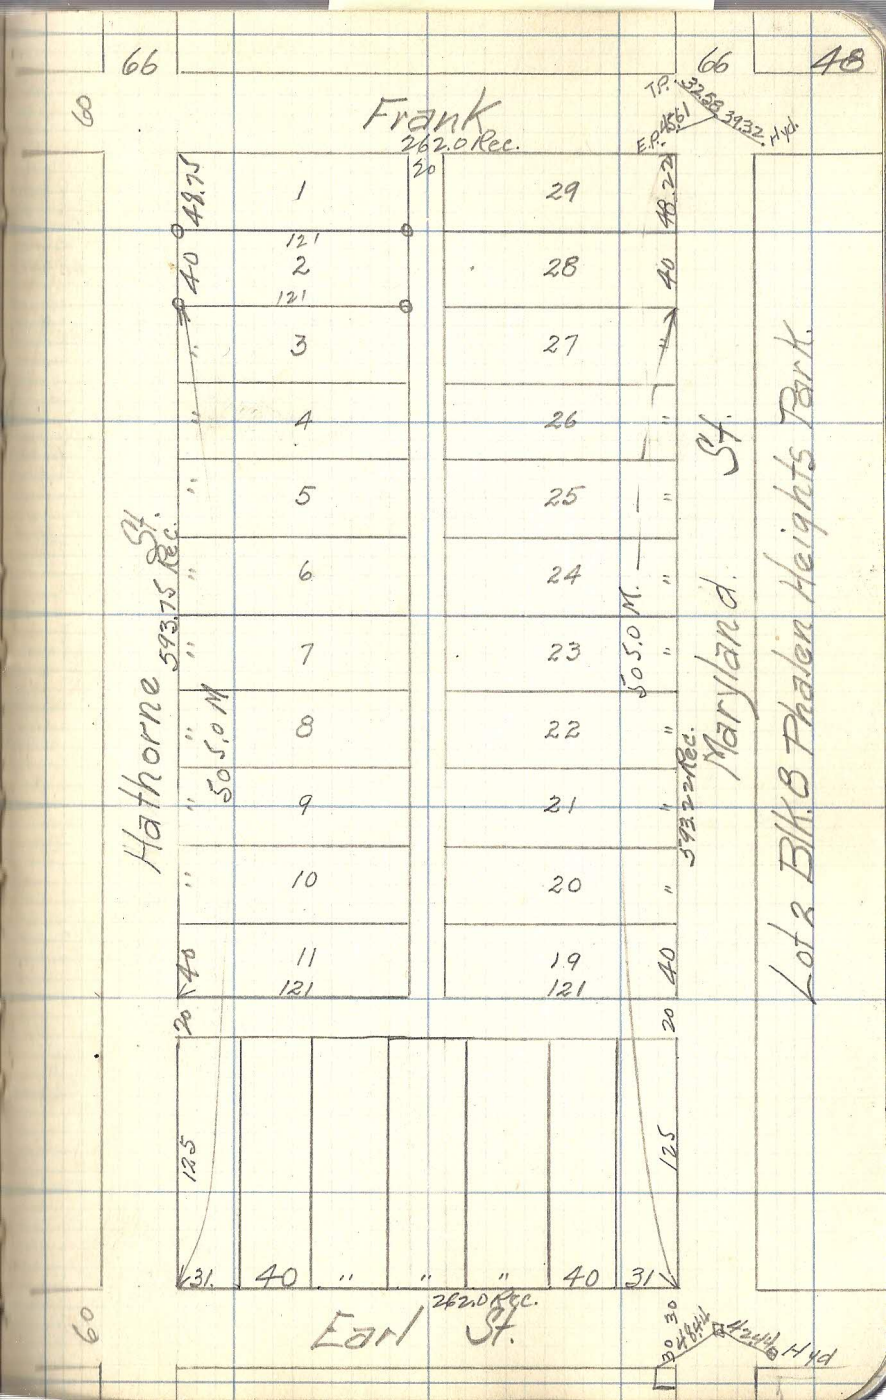
66
66
48
60
Frank
2620 Rec.
T.P. 3259 3932 Hyd.
E.P. 1661
20
1
29
49.75
48.25
121
2
28
40
40
121
3
27
"
"
4
26
"
"
5
25
"
"
6
24
"
"
7
23
"
"
8
22
"
"
9
21
"
"
10
20
"
"
11
19
40
40
121
121
Hathorne St.
593.75 Rec.
50.5.0 M.
50.5.0 M.
593.75 Rec.
Maryland St.
Lot 2 Blk. 8 Phalen Heights Park.
20
20
125
125
31
40
"
"
"
40
31
2620 Rec.
Earl St.
30
60