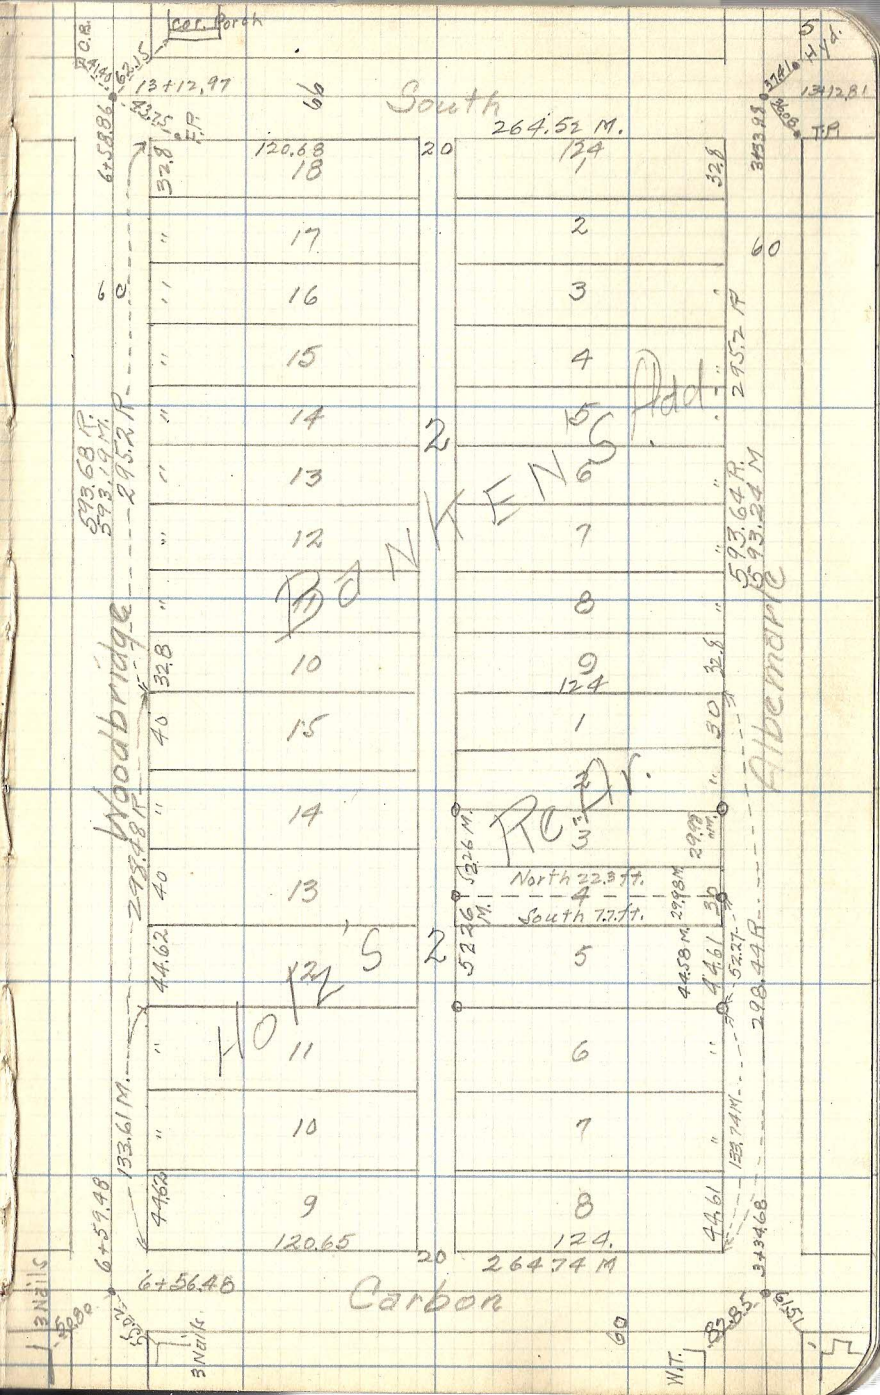

cor. Porch
C.R.
13+12.97
South
264.52 M.
120.68
20
124
18
17
16
15
14
13
12
11
10
9
1
2
3
4
5
6
7
8
9
124
1
2
3
4
5
6
7
8
120.65
124.
264.74 M
Carbon
Woodbridge
Albemarle
Hol's
Re Ar.
North 22.3 ft.
South 7.7 ft.
Hyd.
T.P.
6+58.86
6+59.48
6+56.48
3+34.68
3+33.98
3+41.40
13+12.81
593.68 R.
593.19 M.
295.2 R.
593.64 R.
593.24 M
295.2 R
298.48 R.
133.61 M.
133.74 M.
298.44 R.
52.26 M.
52.26 M.
29.98 M.
29.98 M.
44.58 M.
44.62
44.62
44.61
44.61
32.8
32.8
32.8
32.8
40
40
30
30
60
60
60
60
3 Nails
3 Nails
W.T.