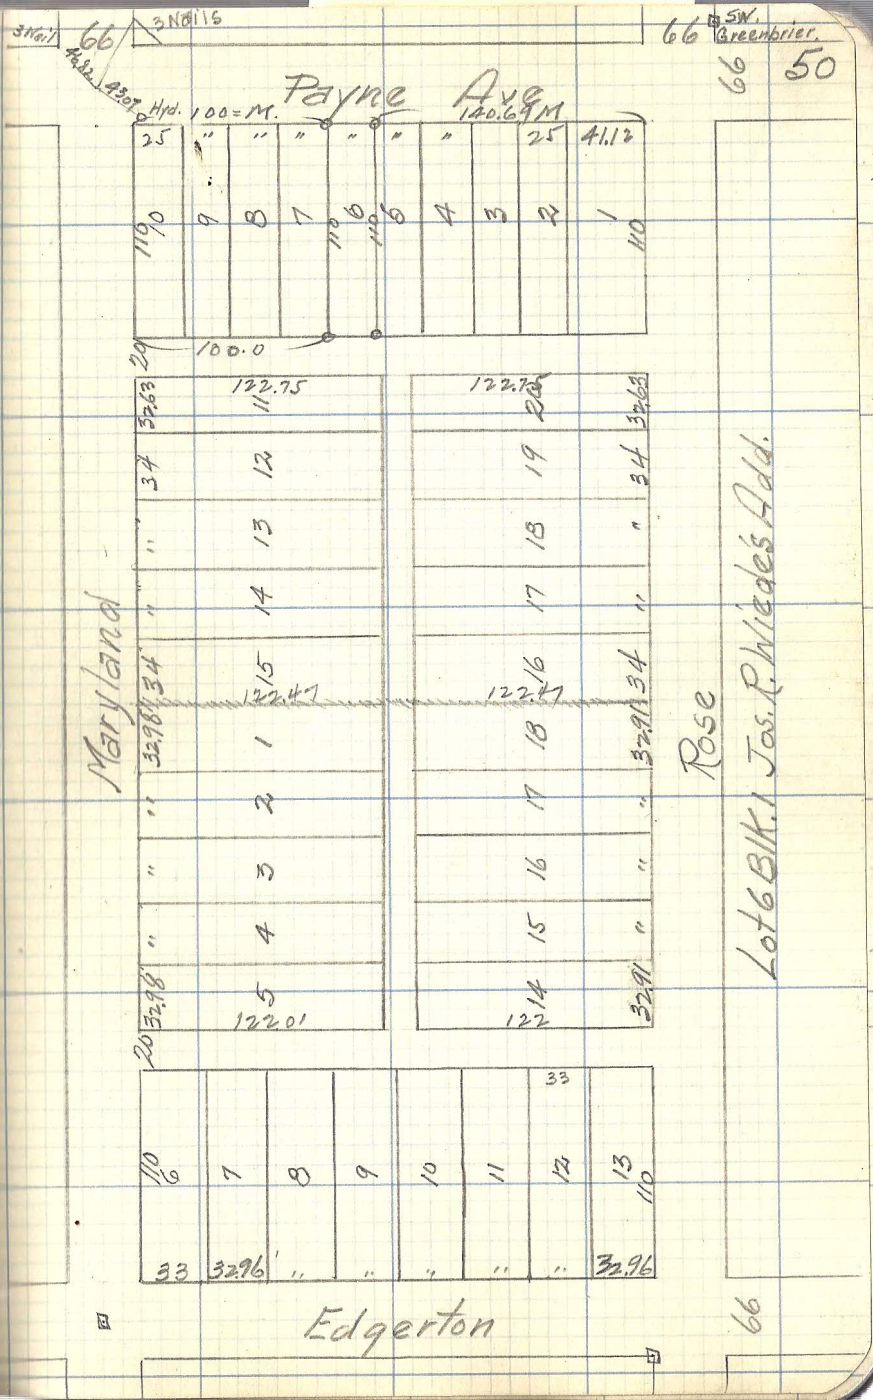
3 Nails
66
66
SW. Greenbrier
50
Payne Ave
100=M.
140.6 M
Hyd.
25
41.12
110
100.0
122.75
32.63
34
Maryland
32.98
122.47
32.98
122.01
122
32.91
Rose
Lot 6 Blk 1 Jas. P. Wades Add.
33
32.96
Edgerton