


Cypress

Forest

Cook St.

Lawson

Lot 29 Bk 2 Forestdale Add.

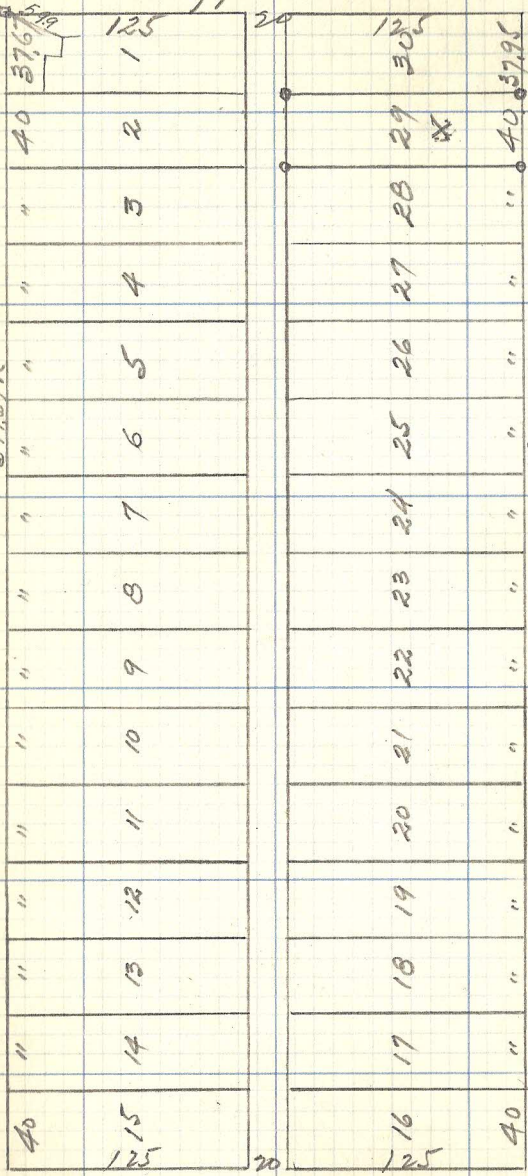

597.67 R

597.85 R

T.P.

Trucks House.

Tree

60 55

55 52

60 55

55 55