Arden Dairy Farms.
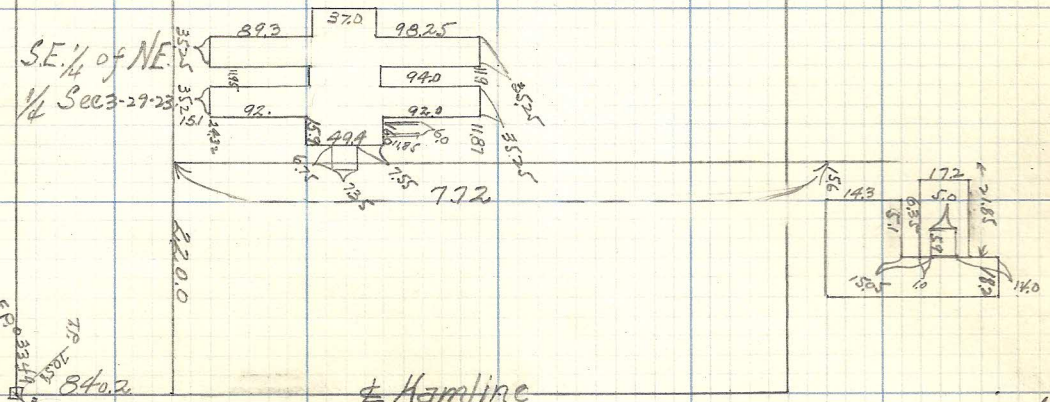
Gov. Lot 4.