S.W¼ Sec. 12-29-23

657.63
1315.26

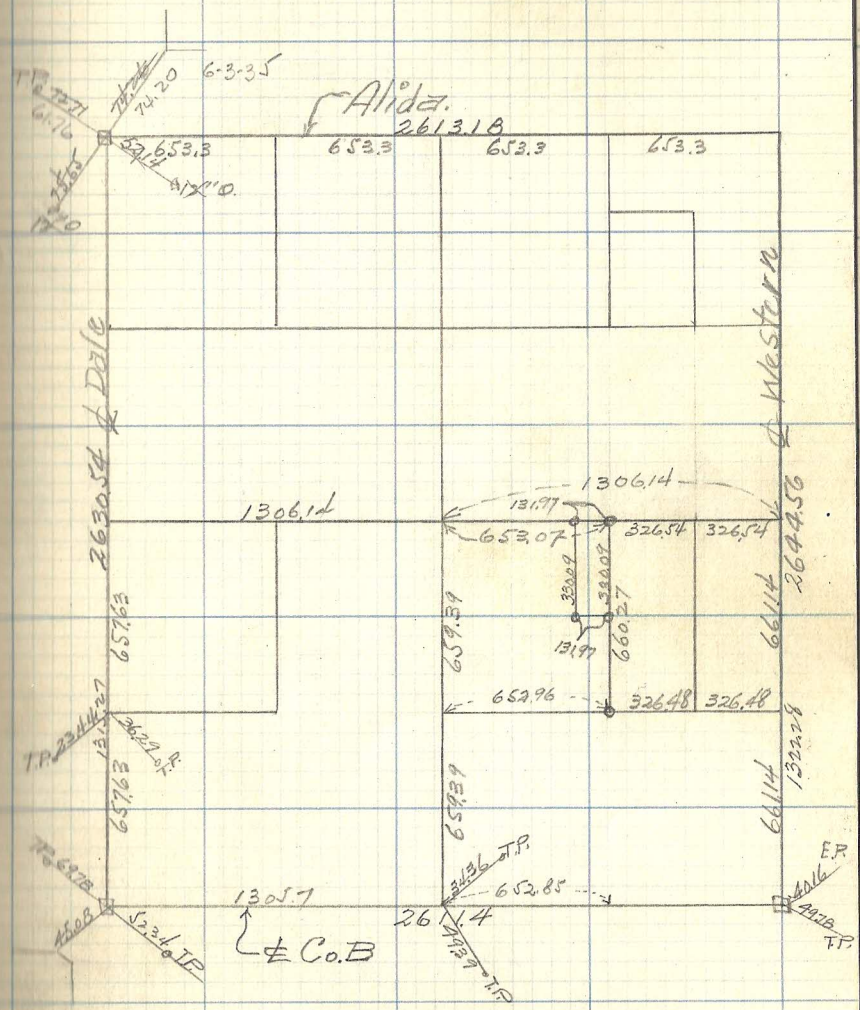


C.W. Zwieg