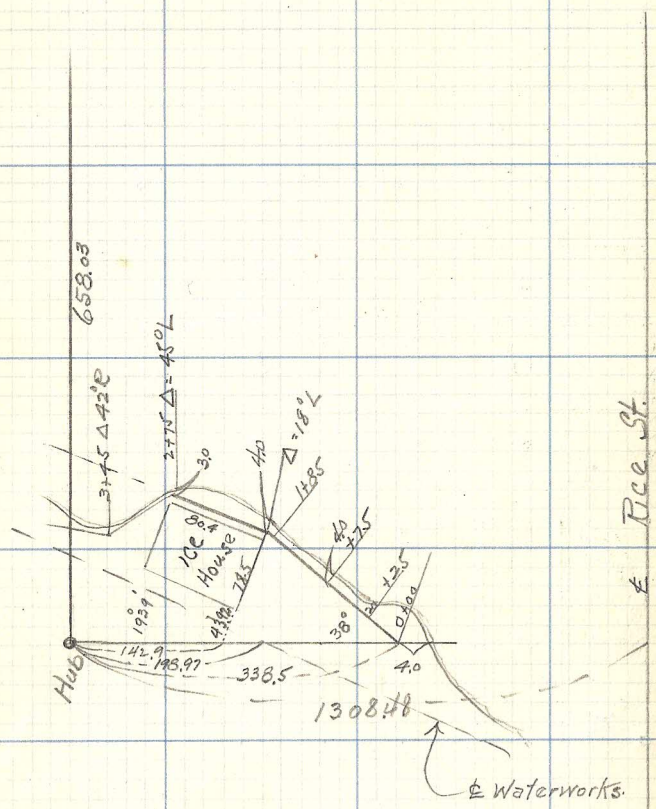
658.03
3+45 Δ 42°R
2+75 Δ = 45°L
3.0
4.0
Δ = 18°L
1+85
80.4
Ice House
78.5
4.0
+7.5
+2.5
0+00
38°
193.9'
142.9
198.97
338.5
4.0
1308.48
Hub
℄ Waterworks.
℄ Rice St.

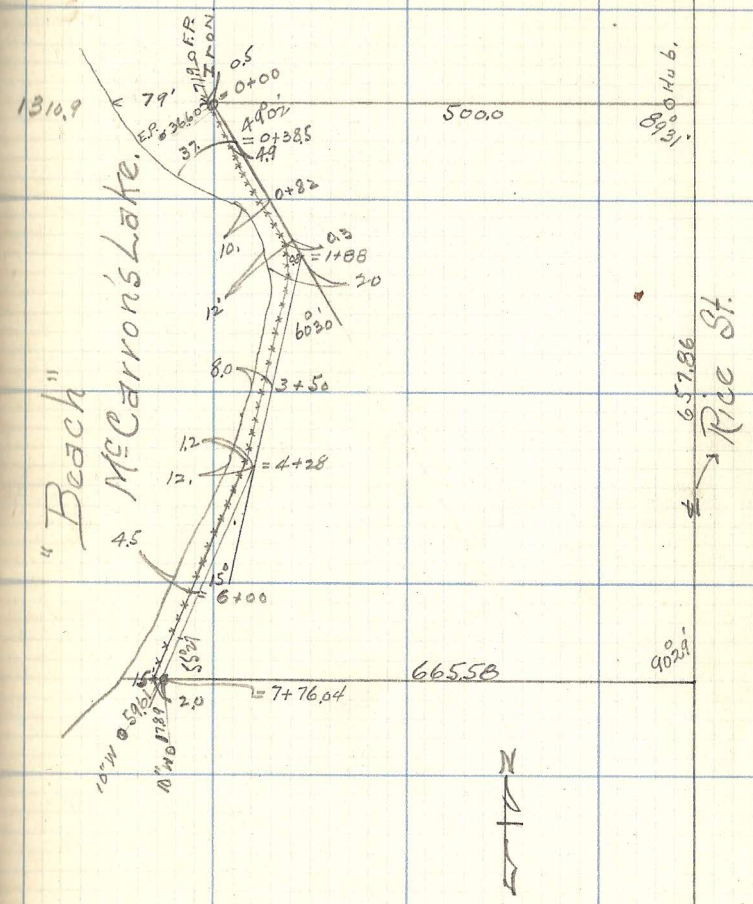
1310.9
79'
0.5
0+00
49°02'
= 0+38.5
37
4.9
0+82
10.
0.3
= 1+88
20
12'
60°30'
8.0
3+50
1.2
12.
= 4+28
4.5
15°
6+00
15
2.0
= 7+76.04
665.58
90°29'
500.0
89°31'
657.86
℄ Rice St.
"Beach"
McCarron's Lake.
N