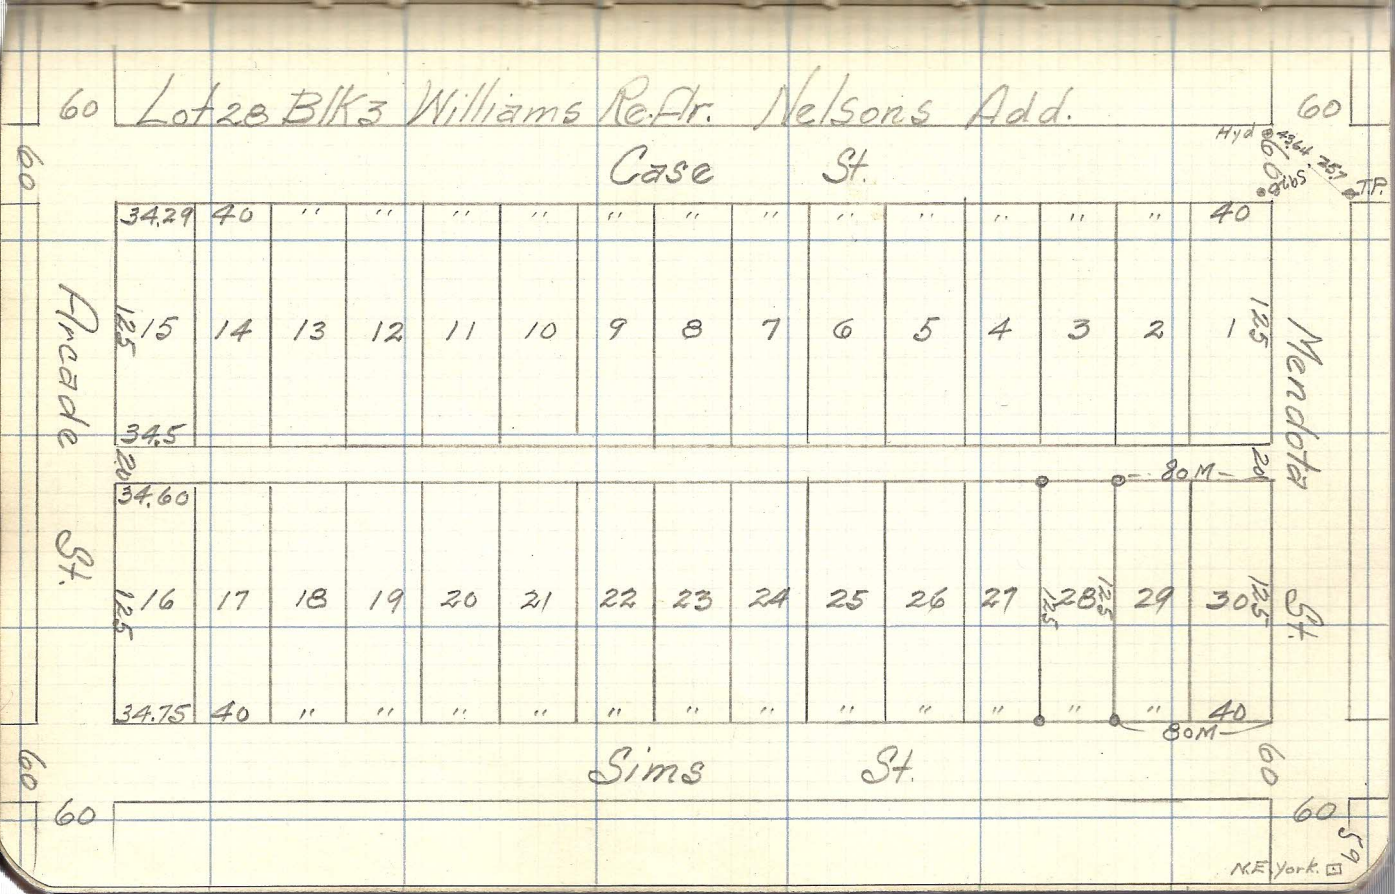
Lot 28 Blk 3 Williams Re-Fr. Nelsons Add.
Case St.
Hyd
T.P.
Arcade St.
Mendota St.
Sims St.
80 M
80 M
N.E. York.