


60. All of Lot 8 & N. 6.2d of Lot 9 Bk. 3 Kavanagh & Dawson's Add.

3054  
 6+30.27  
 40  
 St. 9100 To E Carpenter  
 40

Mississippi

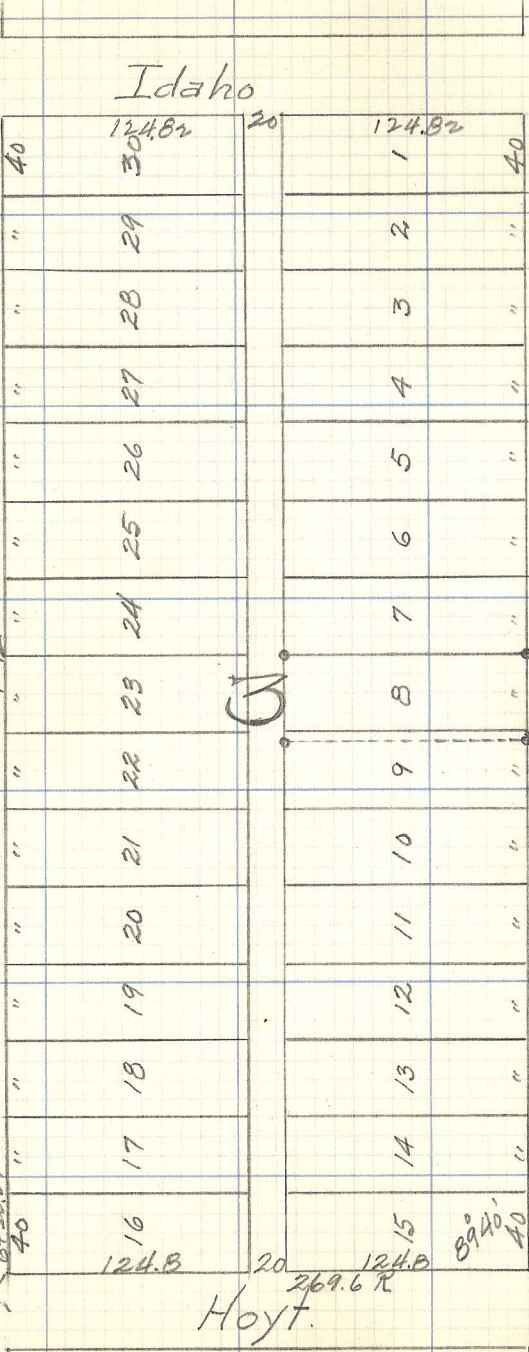

Idaho

124.82  
 304.82

124.82

Hoyt

9100 To E Carpenter  
 Sloan

301.80

60 60

60

60