



60  
60

Winona  
250.08M

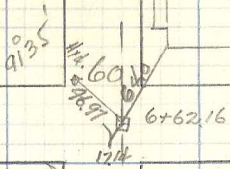


Chippewa

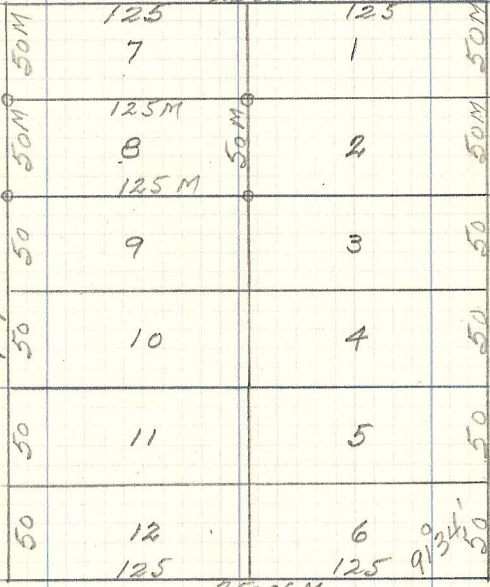

DelaWare

60  
60

Wyoming

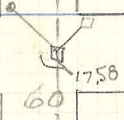

Lot 8 BIK 77  
 Banning & Olivejer's  
 Add.  
 May. 11-26