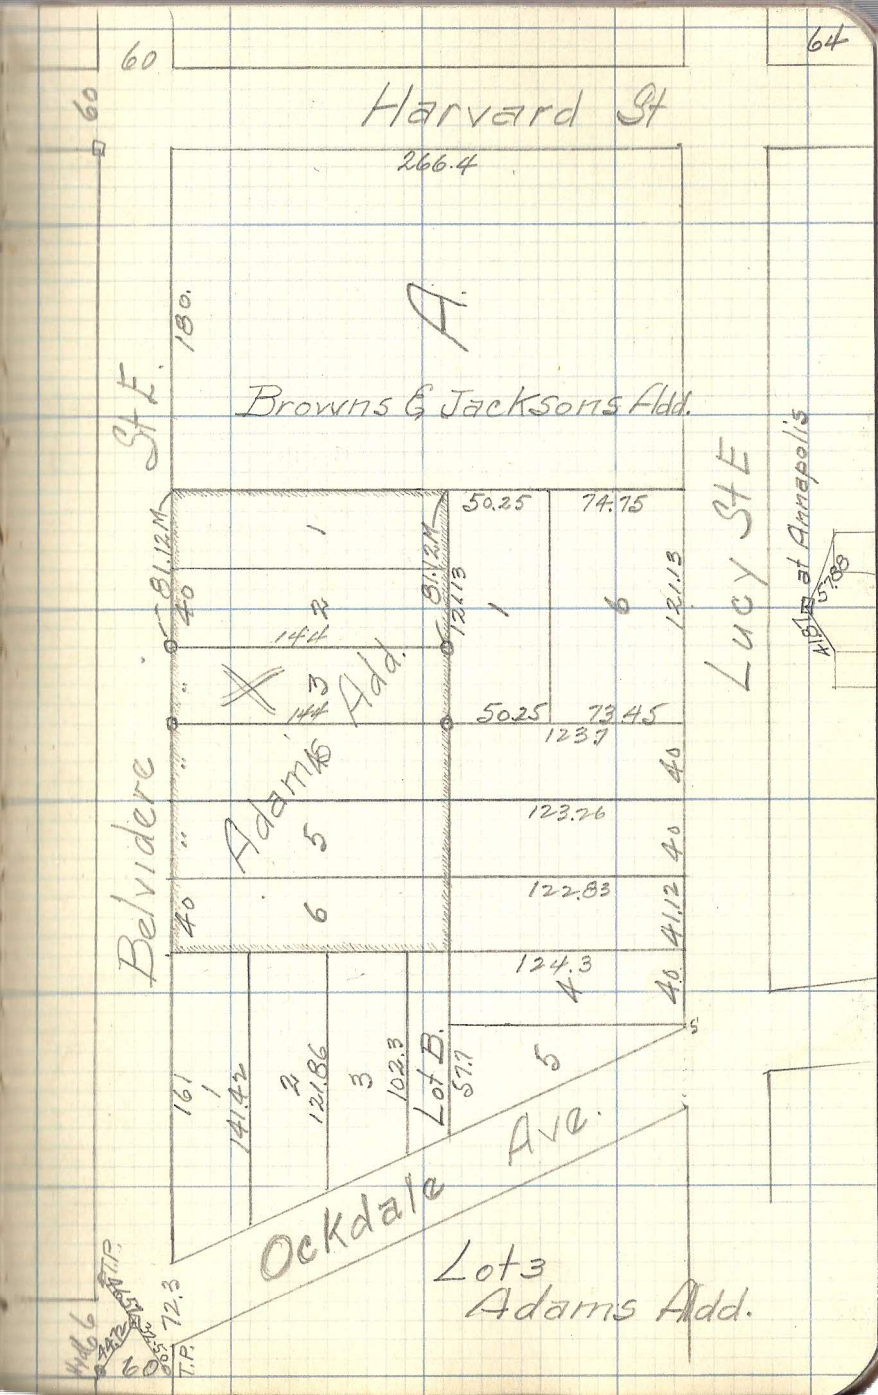
60
Harvard St
266.4
60
A.
Browns & Jacksons Add.
St E.
180.
Belvidere
Adams Add.
Lucy St E
Alley
50.25
74.75
50.25
73.45
123.7
123.26
122.83
124.3
Lot B.
Ockdale Ave.
Lot 3
Adams Add.
72.3