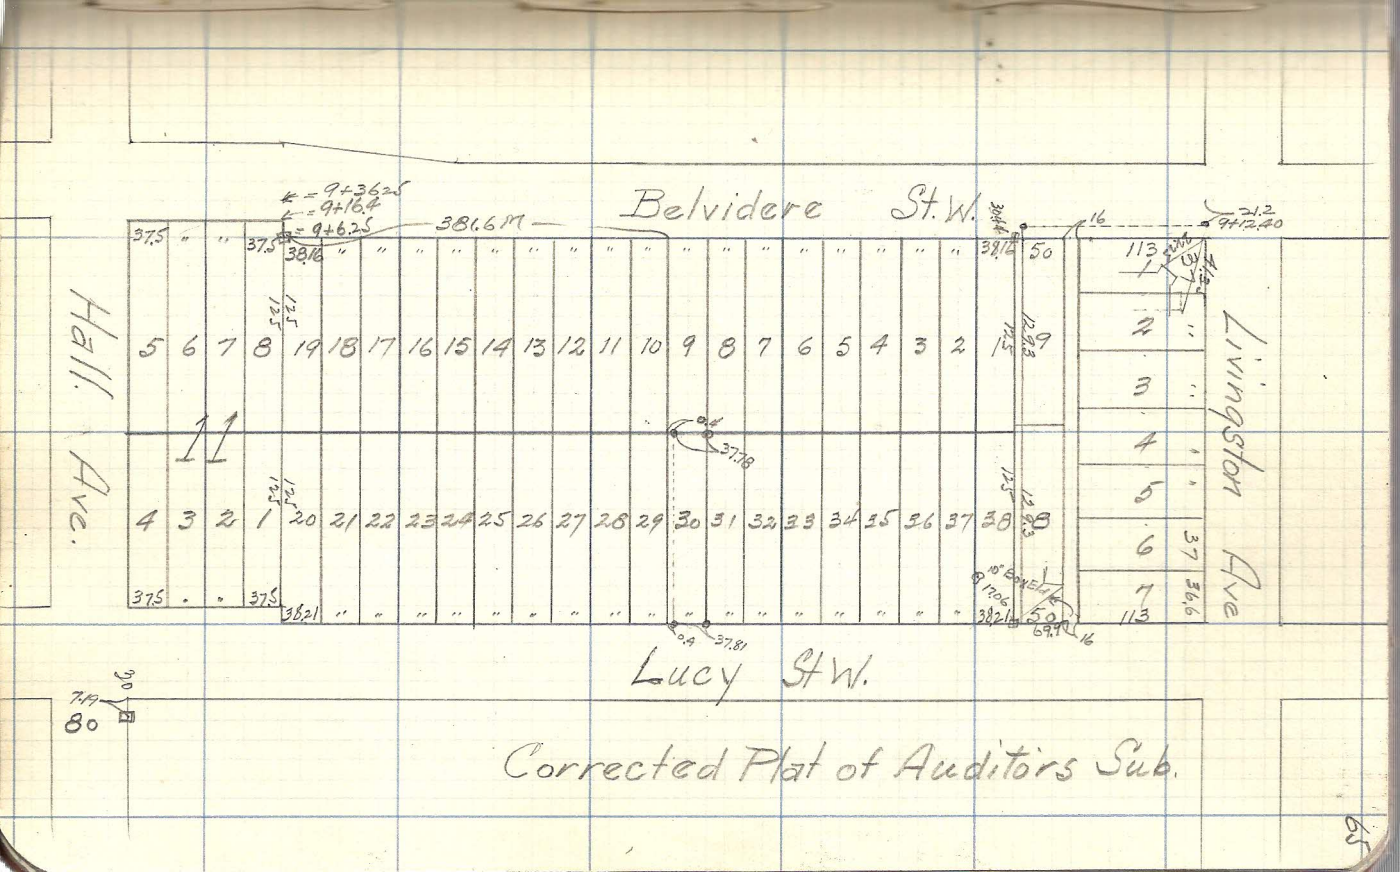
Belvidere St. W.
Lucy St W.
Hall Ave.
Livingston Ave
381.6M
℄ = 9+36.25
℄ = 9+16.4
℄ = 9+6.25
℄ = 9+12.40
11
Corrected Plat of Auditors Sub.