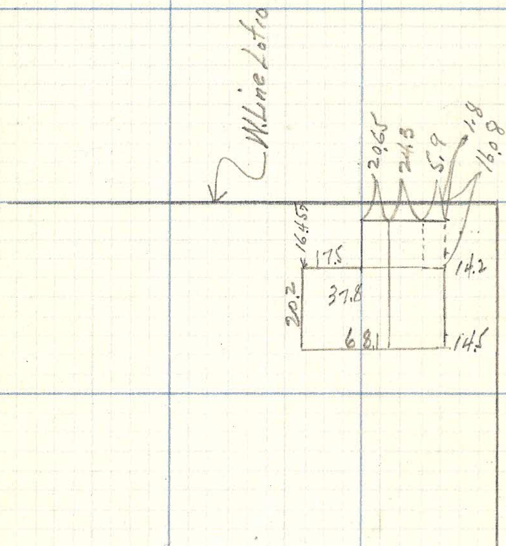
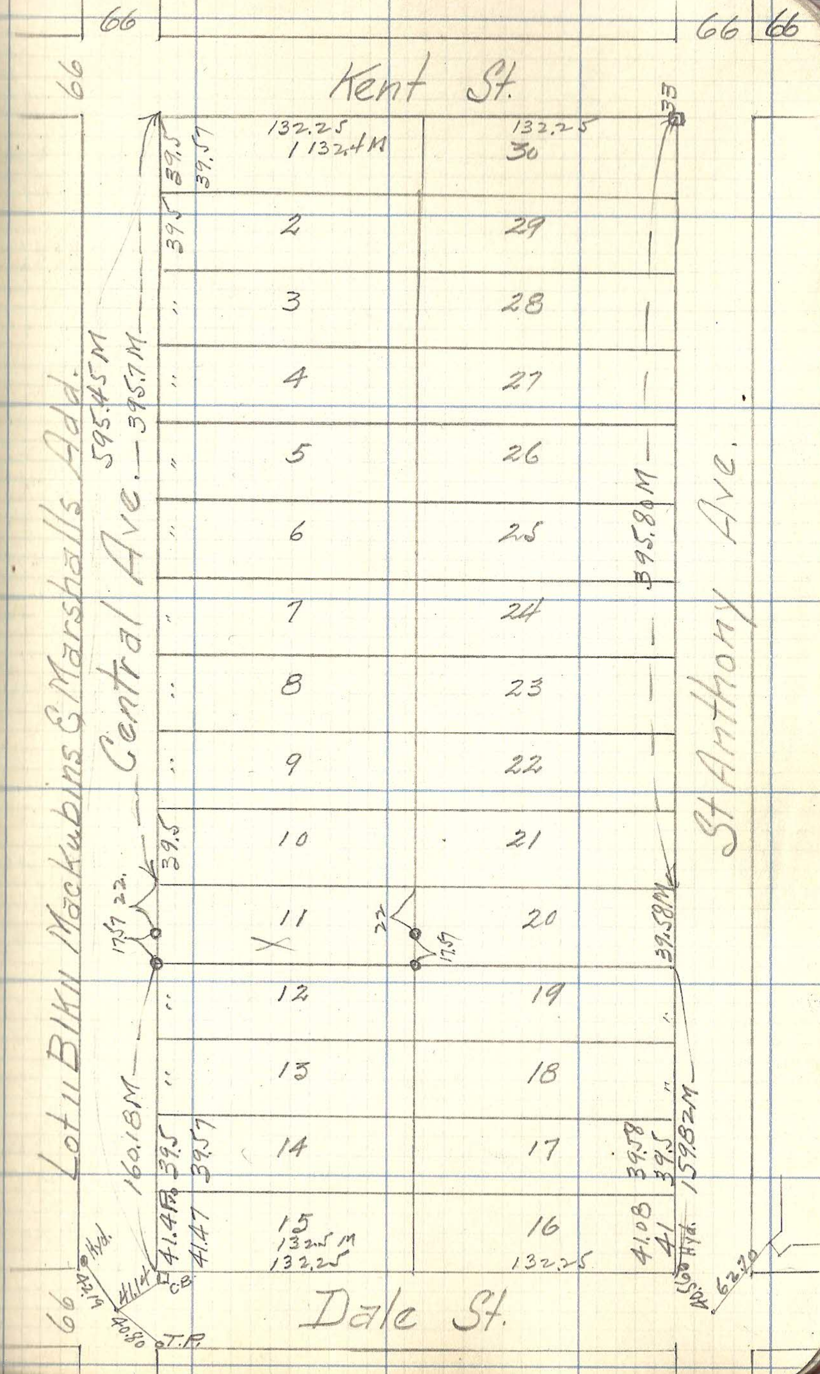
Location Bldg Lot 11 Blk 11
Mackubins & Marshalls Add.